

1995 STATE OF MICHIGAN REMONUMENTATION

PRESQUE ISLE COUNTY  
RECORDED

2653

JAN 17 1996

LAND CORNER RECORDATION CERTIFICATE  
Filing Requirement of Act 74, Mich. P.A. 1970

95 DEC 14 AM 10:29

For corners in

Presque Isle Located In: Corner Code #  
(County)

- |                                    |   |            |   |           |           |
|------------------------------------|---|------------|---|-----------|-----------|
| 1. Public Land Survey              | T | <u>36N</u> | R | <u>2E</u> | <u>G2</u> |
|                                    | T |            | R |           |           |
|                                    | T |            | R |           |           |
|                                    | T |            | R |           |           |
| 2. Property Controlling in Section | S |            | T | R         |           |
|                                    | S |            | T | R         |           |
| 3. Miscellaneous Property in Sec.  | S |            | T | R         |           |
|                                    | S |            | T | R         |           |

*Janet M. Smith*  
REGISTER OF DEEDS

LIBER **316** PAGE **940**

Register of Deeds Stamp & File Number

4. Lot No. \_\_\_\_\_, Recorded Plat \_\_\_\_\_  
5. Private Claims \_\_\_\_\_


A	B	C	D	E	F	G	H	I	J	K	L	M
2	6	5	4	3	2	1						
3												
4	7	8	9	10	11	12						
5												
6	18	17	16	15	14	13						
7												
8	19	20	21	22	23	24						
9												
10	30	29	28	27	26	25						
11												
12	31	32	33	34	35	36						
13												

I, James A. Beck in a field survey on Nov 13, 19 95, do hereby certify that under requirements of P.A. 74, Michigan P.A. of 1970, the corner points mentioned in lines 1 and 2 above were in conformance with regulations and rules therefore as required in the current manual of survey instructions of the United States Department of the Interior, Bureau of Land Management or by a decree of a Court of Law and/or that the corner points mentioned in lines 3, 4 and 5 above were in conformance with the rules of the Michigan Board of Land Surveyors or by a Decree of a Court of Law; established, re-established, monumented, re-monumented, recovered, found as expressed below:

**NOTE: Not more than 4 corners, all in the same town and range, may be recorded on this certificate.**

A. Description of original monument and accessories and/or subsequent restoration:

G2 1856: Government Resurvey \*Resurvey by Geo. H. Cannon  
Set post and referenced:  
Spruce 4" N85°W 7 1/2 Links  
Spruce 4" S60°E 5 Links

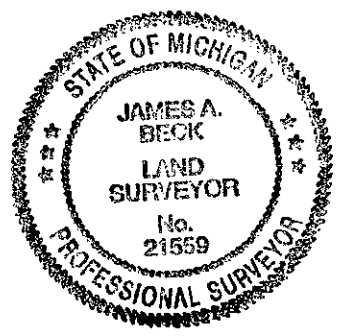

B. Description of corner evidence found and/or method applied in restoring or reestablishing corner:

G2  
November 13, 1995  
Remonumentation by James A. Beck  
P.S. 21559  
Set 1/2" iron rod and P.S. 21559 cap at single proportionate measure between corner common to Sections 3, 4, 9, and 10, and proportioned to G.L.O measure to stream crossing North and on line to corner on Town line common to Sections 3 and 4 by Norman Quaine P.S. 33984

C. Description of monument for corner and accessories established to perpetuate locating the position of the corner:

G2 1/2" iron rod with P.S. 21559 cap  
Witnesses:  
S 63°E 15.60', 5" Cedar  
S 22°E 19.13', 6" Cedar  
S 23°W 15.00', 5" Cedar  
N 35°W 15.28', 4" Cedar  
P.S. 21559 witness tags set in witness trees

Ratified by Peer Group in accordance with P.A. 345  
Chairman *[Signature]*  
Date 11/21/95

Signed by James A. Beck Date 11-28-1995  
Surveyor's Michigan License No. 21559