

1995 STATE OF MICHIGAN REMONUMENTATION

JAN 17 1996

PRESQUE ISLE COUNTY
RECORDED

2654

COMMISSION LAND CORNER RECORDATION CERTIFICATE

Filing Requirement of Act 74, Mich. P.A. 1970

95 DEC 14 AM 10:29

For corners in

Presque Isle Located In: _____ Corner Code # G3
(County)

1. Public Land Survey	T <u>36</u> N <u>2E</u>	<u>G3</u>
	T _____ R _____	_____
	T _____ R _____	_____
	T _____ R _____	_____
2. Property Controlling in Section	S _____ T _____ R _____	_____
	S _____ T _____ R _____	_____
3. Miscellaneous Property in Sec.	S _____ T _____ R _____	_____
	S _____ T _____ R _____	_____

Janet M. Lamb
REGISTER OF DEEDS

LIBER **316** PAGE **941**

Register of Deeds Stamp & File Number

4. Lot No. _____, Recorded Plat _____
5. Private Claims _____

	A	B	C	D	E	F	G	H	I	J	K	L	M
2	6		5		4		3		2		1		
3							⊕						
4	7		8		9		10		11		12		
5													
6	18		17		16		15		14		13		
7													
8	19		20		21		22		23		24		
9													
10	30		29		28		27		26		25		
11													
12	31		32		33		34		35		36		
13													

I, James A. Beck in a field survey on Oct. 23, 1995, do hereby certify that under requirements of P.A. 74, Michigan P.A. of 1970, the corner points mentioned in lines 1 and 2 above were in conformance with regulations and rules therefore as required in the current manual of survey instructions of the United States Department of the Interior, Bureau of Land Management or by a decree of a Court of Law and/or that the corner points mentioned in lines 3, 4 and 5 above were in conformance with the rules of the Michigan Board of Land Surveyors or by a Decree of a Court of Law; established, re-established, monumented, re-monumented, recovered, found as expressed below:

NOTE: Not more than 4 corners, all in the same town and range, may be recorded on this certificate.

A. Description of original monument and accessories and/or subsequent restoration:

G3

1856: Government Resurvey * by Geo. H. Cannon	Set post and referenced: W. Pine 14" S75°E 7 Links Spruce 11" N44°W 47 Links
April 1, 1968: ABT Company memo	Steel stake and original bearing tree at corner. South line of section painted.

B. Description of corner evidence found and/or method applied in restoring or reestablishing corner:

G3

October 23, 1995
Remonumentation by
James A. Beck P.S. 21559

found 1" pipe with coupling at corner and 18" hollow White Pine snag, 40"+ high scribed at chest blaze and with root blaze visible (original G.L.O. bearing tree mentioned in ABT Company memo above)

Set 1/2" rod with P.S. 21559 cap inside pipe found


Witnesses:
S 75°E 4.62' (7 links) to root blaze, Original G.L.O. Bearing tree 18" hollow White Pine Stub

Ratified by Peer Group
in accordance with P.A. 345
Chairman *[Signature]*
Date 11/21/95

C. Description of monument for corner and accessories established to perpetuate locating the position of the corner:

G3 1/2" rod with P.S. 21559 cap inside 1-1/2" pipe found

Witnesses:
S 75°E 4.62' (7 links) to root blaze, Original G.L.O. Bearing tree 18" hollow White Pine Stub
N 44°W 31.5' + - to fallen stump, blaze side down (possible original bearing tree)
S 62°E 20.12', 4" White Birch, set P.S. 21559 tag
S 22°E 22.98', 6" Balsam, set P.S. 21559 tag
S 57°W 30.06' Southerly stem of 10" Twin Cedar, set P.S. 21559 tag
N 3°E 4.02', 5" Maple, set P.S. 21559 tag

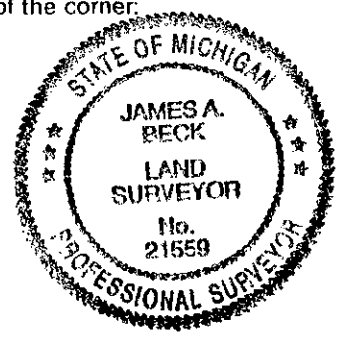

Signed by James A. Beck Date 11-28-1995
Surveyor's Michigan License No. 21559