

SURVEY & MONUMENTATION

1995 STATE OF MICHIGAN REMONUMENTATION

JAN 17 1996

PRESQUE ISLE COUNTY
RECORDED

2656

COMMISSION

LAND CORNER RECORDATION CERTIFICATE 95 DEC 14 AM 10:29
Filing Requirement of Act 74, Mich. P.A. 1970

For corners in

Presque Isle Located In: _____
(County)

Corner Code #

Janet M. Lamb
REGISTER OF DEEDS

- | | | | | |
|------------------------------------|---|------------|-----------|-----------|
| 1. Public Land Survey | T | <u>36N</u> | <u>2E</u> | <u>G6</u> |
| | T | _____ | _____ | _____ |
| | T | _____ | _____ | _____ |
| | T | _____ | _____ | _____ |
| 2. Property Controlling in Section | S | _____ | _____ | _____ |
| | S | _____ | _____ | _____ |
| 3. Miscellaneous Property in Sec. | S | _____ | _____ | _____ |
| | S | _____ | _____ | _____ |

LIBER **316** PAGE **943**

Register of Deeds Stamp & File Number

4. Lot No. _____, Recorded Plat _____
5. Private Claims _____

| | A | B | C | D | E | F | G | H | I | J | K | L | M |
|----|----|----|----|----|----|----|---|---|---|---|---|---|---|
| 2 | 6 | 5 | 4 | 3 | 2 | 1 | | | | | | | |
| 3 | | | | | | | | | | | | | |
| 4 | 7 | 8 | 9 | 10 | 11 | 12 | | | | | | | |
| 5 | | | | | | | | | | | | | |
| 6 | 18 | 17 | 16 | 15 | 14 | 13 | | | | | | | |
| 7 | | | | | | | | | | | | | |
| 8 | 19 | 20 | 21 | 22 | 23 | 24 | | | | | | | |
| 9 | | | | | | | | | | | | | |
| 10 | 30 | 29 | 28 | 27 | 26 | 25 | | | | | | | |
| 11 | | | | | | | | | | | | | |
| 12 | 31 | 32 | 33 | 34 | 35 | 36 | | | | | | | |
| 13 | | | | | | | | | | | | | |


I, James A. Beck in a field survey on Oct. 31, 1995, do hereby certify that under requirements of P.A. 74, Michigan P.A. of 1970, the corner points mentioned in lines 1 and 2 above were in conformance with regulations and rules therefore as required in the current manual of survey instructions of the United States Department of the Interior, Bureau of Land Management or by a decree of a Court of Law and/or that the corner points mentioned in lines 3, 4 and 5 above were in conformance with the rules of the Michigan Board of Land Surveyors or by a Decree of a Court of Law; established, re-established, monumented, re-monumented, recovered, found as expressed below:

NOTE: Not more than 4 corners, all in the same town and range, may be recorded on this certificate.

A. Description of original monument and accessories and/or subsequent restoration:

G6 1856: Government Resurvey
* Geo. H. Cannon
Set post and referenced:
W. Pine 6" N40°W 14 Links
W. Pine 7" S50°E 15 1/2 Links

Sept. 22, 1976:
Corner recorded by
Ronald Bischer,
P.S. 22428.
Set 1/2" rod by single proportion.
Referenced:
N25°E 13.60 18" N. Pine
S89°E 19.28 10" Cedar
S48°W 15.09 12" Cedar

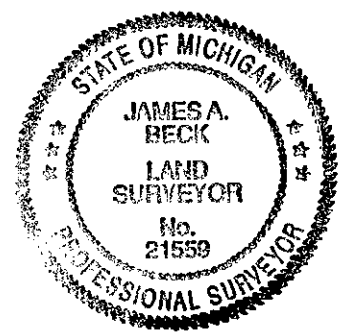

B. Description of corner evidence found and/or method applied in restoring or reestablishing corner:

G6
October 31, 1995
Remonumentation
by James A. Beck
P.S. 21559

Found R.L.S. 15410 (Delmer Porter) 1/2" iron rod and identification cap and all previously recorded witnesses:
N 25°E 13.60', 16" Norway Pine
S 89°E 19.28' 13" Cedar
S 48°W 15.09' 14" Cedar

C. Description of monument for corner and accessories established to perpetuate locating the position of the corner:

G6
1/2" iron with R.L.S. 15410 cap
N 25°E 13.60', 16" Norway Pine (R.L.S. 15410 tag)
S 89°E 19.28' 13" Cedar (R.L.S. 15410 tag)
S 48°W 15.09' 14" Cedar (R.L.S. 21559 tag)
New Witnesses:
N 7°W 28.22', 9" Norway Pine (P.S. 21559 tag)
S 70°W 27.75', 22" White Pine (P.S. 21559 tag)

Ratified by Peer Group
in accordance with P.A. 345
Chairman Delmer E. Porter
Date 11/21/95

Signed by James A. Beck Date 11-28-1995
Surveyor's Michigan License No. 21559