

LAND CORNER RECORDATION CERTIFICATE
Filing Requirement of Act 74, Mich. P.A. 1970

94 SEP 12 AM 10:41

For corners in

Presque Isle (County) Located In: Corner Code #

1. Public Land Survey T 36N R 2E G-8
 T R
 T R
 T R

2. Property Controlling S T R
 in Section S T R

3. Miscellaneous S T R
 Property in Sec. S T R

4. Lot No. _____, Recorded Plat _____

5. Private Claims _____

Janet M. Lamb
REGISTER OF DEEDS

LIBER 311 PAGE 249

Register of Deeds Stamp & File Number

I, James A. Beck, in a field survey on June 20, 19 94, do hereby certify that under requirements of P.A. 74, Michigan P.A. of 1970, the corner points mentioned in lines 1 and 2 above were in conformance with regulations and rules therefore as required in the current manual of survey instructions of the United States Department of the Interior, Bureau of Land Management or by a decree of a Court of Law and/or that the corner points mentioned in lines 3, 4 and 5 above were in conformance with the rules of the Michigan Board of Land Surveyors or by a Decree of a Court of Law: established, re-established, monumented, re-monumented, recovered, found as expressed below:

	A	B	C	D	E	F	G	H	I	J	K	L	M
2	6	5	4	3	2	1							
3													
4	7	8	9	10	11	12							
5													
6	18	17	16	15	14	13							
7													
8	19	20	21	22	23	24							
9													
10	30	29	28	27	26	25							
11													
12	31	32	33	34	35	36							
13													

NOTE: Not more than 4 corners, all in the same town and range, may be recorded on this certificate.

A. Description of original monument and accessories and/or subsequent restoration:

G-8
1856: Original monumentation in Government Resurvey. Set post at quarter section and referenced:
Spruce 10" S75°W 17 Links
Cedar 9" South 9 Links


B. Description of corner evidence found and/or method applied in restoring or reestablishing corner:

G-8
1994: Found 1/2" iron rod and cap P.S. 21559 as recorded by James A. Beck, P.S. 21559 (recorded October 30, 1992, L. 303, P. 317, Presque Isle County Records). Witnesses found (as recorded):
South 6.08' 24" Cedar (old blaze & scribe)
S65°E 14.97' 4" White Birch
S40°E 12.68' 5" White Birch
S30°W 31.72' 18" Cedar

Ratified by Peer Group in accordance with P.A. 345
Chairman *Delmer E. Pate*
Date August 29, 1994

C. Description of monument for corner and accessories established to perpetuate locating the position of the corner:

G-8
1994: 1/2" iron rod and cap P.S. 21559. Witnesses:
South 6.08' 24" Cedar (old blaze & scribe)
S65°E 14.97' 4" White Birch
S40°E 12.68' 5" White Birch
S30°W 31.72' 18" Cedar

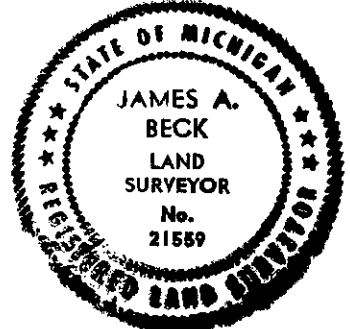

Signed by *James A. Beck*
Surveyor's Michigan License No. 21559

Date August 25, 1994