

State of Michigan Remonumentation Program
For Presque Isle County

PRESQUE ISLE COUNTY
RECORDED

LAND CORNER RECORDATION CERTIFICATE
Filing Requirement of Act 74, Mich. P.A. 1970

94 AUG 23 AM 10:10

For corners in

PRESQUE ISLE
(County)

Located In:

Corner Code #

- | | | |
|---------------------------------------|-------------------------|-------|
| 1. Public Land Survey | T 36N R 2E | G-10 |
| | T _____ R _____ | _____ |
| | T _____ R _____ | _____ |
| | T _____ R _____ | _____ |
| 2. Property Controlling
in Section | S _____ T _____ R _____ | _____ |
| | S _____ T _____ R _____ | _____ |
| 3. Miscellaneous
Property in Sec. | S _____ T _____ R _____ | _____ |
| | S _____ T _____ R _____ | _____ |

Jane M. Lamb
REGISTER OF DEEDS

LIBER 310 PAGE 928

Register of Deeds Stamp & File Number

4. Lot No. _____, Recorded Plat _____
5. Private Claims _____

	A	B	C	D	E	F	G	H	I	J	K	L	M
2	6	5	4	3	2	1							
3													
4	7	8	9	10	11	12							
5													
6	18	17	16	15	14	13							
7													
8	19	20	21	22	23	24							
9													
10	30	29	28	27	26	25							
11													
12	31	32	33	34	35	36							
13													

I, Ronald Bischer, in a field survey on May 4, 19 94, do hereby certify that under requirements of P.A. 74, Michigan P.A. of 1970, the corner points mentioned in lines 1 and 2 above were in conformance with regulations and rules therefore as required in the current manual of survey instructions of the United States Department of the Interior, Bureau of Land Management or by a decree of a Court of Law and/or that the corner points mentioned in lines 3, 4 and 5 above were in conformance with the rules of the Michigan Board of Land Surveyors or by a Decree of a Court of Law; established, re-established, monumented, re-monumented, recovered, found as expressed below:

NOTE: Not more than 4 corners, all in the same town and range, may be recorded on this certificate.


A. Description of original monument and accessories and/or subsequent restoration:

- | | | | | |
|----------------------------|-------|--------|-----|--------|
| 1856 Resurvey - GLO Notes | S09°E | 26.62' | 18" | Spruce |
| Set Wood Post | S57°W | 31.16' | 6" | Cedar |
| W. Pine 24" S67°E 22 links | N59°W | 8.34' | 6" | Cedar |
| W. Birch 7" N67°W 31 links | | | | |

- 9-22-75 - Delmar E. Porter
Set 1/2" Rod and Cap #15410
from O.B.T.
S67°E 14.52' W. Pine O.B.T Stump

B. Description of corner evidence found and/or method applied in restoring or reestablishing corner:

- Found 1/2" Rod and Cap #15410
S67°E 14.52' W. Pine O.B.T. stump
stump in place, blaze facing corner
S09°E 26.62' 18" Spruce
S57°W 16.57' 8" Cedar
N59°W 8.45' 8" Cedar

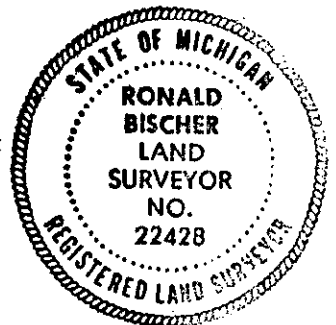

SURVEY &
REMONUMENTATION

SEP 09 1994

COMMISSION

C. Description of monument for corner and accessories established to perpetuate locating the position of the corner:

- 1/2" Rod and Cap #15410
S67°E 14.52' W. Pine O.B.T. stump
S09°E 26.62' 18" Spruce
S57°W 16.57' 8" Cedar
N59°W 8.45' 8" Cedar
S56°E 16.63' 5" Cedar

Ratified by Peer Group
in accordance with P.A. 345
Chairman Delmar E. Porter
Date July 27, 1994

Witness tags w/nails used.

Signed by Ronald R. Bischer Date July 20, 1994
Surveyor's Michigan License No. 22428