

State of Michigan Remonumentation Program
For Presque Isle County

PRESQUE ISLE COUNTY
RECORDED

LAND CORNER RECORDATION CERTIFICATE
Filing Requirement of Act 74, Mich. P.A. 1970

94 AUG 23 AM 10:13

For corners in

PRESQUE ISLE
(County)

Located In:

Corner Code #

- | | | |
|---------------------------------------|--------------------------|-------------|
| 1. Public Land Survey | T <u>36N</u> R <u>2E</u> | <u>G-12</u> |
| | T _____ R _____ | _____ |
| | T _____ R _____ | _____ |
| | T _____ R _____ | _____ |
| 2. Property Controlling
in Section | S _____ T _____ R _____ | _____ |
| | S _____ T _____ R _____ | _____ |
| 3. Miscellaneous
Property in Sec. | S _____ T _____ R _____ | _____ |
| | S _____ T _____ R _____ | _____ |

Jane M. Lamb
REGISTER OF DEEDS

LIBER **310** PAGE **944**

Register of Deeds Stamp & File Number

4. Lot No. _____, Recorded Plat _____
5. Private Claims _____

I, Ronald Bischer, in a field survey on May 5, 19 94,
do hereby certify that under requirements of P.A. 74, Michigan P.A. of 1970, the corner points mentioned
in lines 1 and 2 above were in conformance with regulations and rules therefore as required in the
current manual of survey instructions of the United States Department of the Interior, Bureau of Land
Management or by a decree of a Court of Law and/or that the corner points mentioned in lines 3, 4 and 5
above were in conformance with the rules of the Michigan Board of Land Surveyors or by a Decree of a
Court of Law; established, re-established, monumented, re-monumented, recovered, found as
expressed below:

	A	B	C	D	E	F	G	H	I	J	K	L	M
2	6	5	4	3	2	1							
3													
4	7	8	9	10	11	12							
5													
6	18	17	16	15	14	13							
7													
8	19	20	21	22	23	24							
9													
10	30	29	28	27	26	25							
11													
12	31	32	33	34	35	36							
13													

**NOTE: Not more than 4 corners, all in the same town and range, may be recorded
on this certificate.**


A. Description of original monument and accessories and/or subsequent restoration:

- | | | |
|-----------------------------|---------------------------------|----------------------|
| 1856 Resurvey - GLO Notes | S55°W 54.25' | Tw. 8" N. Pine |
| Set Wood Post | 11-04-78 | - Delmar E. Porter |
| Sp. Pine 12" N72°E 43 links | Found 2" Pipe | - Wit. same as above |
| Sp. Pine 10" S72°W 20 links | 11-06-78 | - Delmar E. Porter |
| 1935+ - Marcus Schaaf | Found 2" Pipe, replaced w/conc. | |
| Set 2" Pipe | mon. w/brass cap. | Witnesses |
| 05-29-74 - Delmar E. Porter | same as above | |
| Found 2" Pipe | 07-31-92 - Norman J. Quaine | |
| N45°E 40.45' 6" Norway | Found Remonumentation Monument | |
| S15°E 24.15' 4" Jack Pine | N67°E 58.90' 14" N. Pine | |

B. Description of corner evidence found and/or method applied in restoring or reestablishing corner:

- Found Presque Isle County Remonumentation
Monument
N37°E 40.50' 10" Norway
S67°E 58.90' 16" Norway

- Other witnesses same as in 1978.
08-04-92 - Norman J. Quaine
Found Remonumentation Monument
S15°E 24.15' 4" J. Pine
S55°W 54.25' Tw. 8" N. Pine
N45°E 40.45' 6" N. Pine
S67°E 58.90' 14" N. Pine

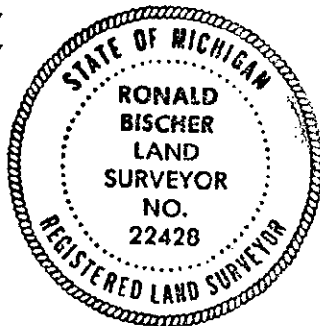

C. Description of monument for corner and accessories established to perpetuate locating the position of the corner:

- Presque Isle County Remonumentation Monument
N37°E 40.50' 10" Norway
S67°E 58.90' 16" Norway
S64°W 54.05' 13" Norway
N24°W 42.90' 16" Norway

Witness tags w/nails used.

Ratified by Peer Group
in accordance with P.A. 345

Chairman *Delmar E. Porter*
Date July 27, 1994

Signed by Ronald R. Bischer

Date July 20, 1994

Surveyor's Michigan License No. 22428