

State of Michigan Remonumentation Program
For Presque Isle County

PRESQUE ISLE COUNTY
RECORDED

LAND CORNER RECORDATION CERTIFICATE
Filing Requirement of Act 74, Mich. P.A. 1970

94 AUG 23 AM 10:11

For corners in

PRESQUE ISLE
(County)

Located In:

Corner Code #

- | | | |
|---------------------------------------|--------------------------|-------------|
| 1. Public Land Survey | T <u>36N</u> R <u>2E</u> | <u>G-13</u> |
| | T _____ R _____ | _____ |
| | T _____ R _____ | _____ |
| | T _____ R _____ | _____ |
| 2. Property Controlling
in Section | S _____ T _____ R _____ | _____ |
| | S _____ T _____ R _____ | _____ |
| 3. Miscellaneous
Property in Sec. | S _____ T _____ R _____ | _____ |
| | S _____ T _____ R _____ | _____ |

Jane M. Lamb
REGISTER OF DEEDS

LIBER **310** PAGE **935**

Register of Deeds Stamp & File Number

4. Lot No. _____, Recorded Plat _____
5. Private Claims _____

I, Ronald Bischer, in a field survey on April 6, 19 94, do hereby certify that under requirements of P.A. 74, Michigan P.A. of 1970, the corner points mentioned in lines 1 and 2 above were in conformance with regulations and rules therefore as required in the current manual of survey instructions of the United States Department of the Interior, Bureau of Land Management or by a decree of a Court of Law and/or that the corner points mentioned in lines 3, 4 and 5 above were in conformance with the rules of the Michigan Board of Land Surveyors or by a Decree of a Court of Law; established, re-established, monumented, re-monumented, recovered, found as expressed below:

	A	B	C	D	E	F	G	H	I	J	K	L	M
2	6		5		4		3		2		1		
3													
4	7		8		9		10		11		12		
5													
6	18		17		16		15		14		13		
7													
8	19		20		21		22		23		24		
9													
10	30		29		28		27		26		25		
11													
12	31		32		33		34		35		36		
13													

NOTE: Not more than 4 corners, all in the same town and range, may be recorded on this certificate.

A. Description of original monument and accessories and/or subsequent restoration:

G-13	1978 - Delmar E. Porter
GLO Notes, Resurvey 1856	Found 1½" pipe, replaced pipe with concrete monument with brass cap
Set Wood Post	N36°W 47.60' 12" Pine
SP. Pine 11" S31°E 79 links	S69°W 49.68' 8" Pine
SP. Pine 11" S08°W 29 links	S37°E 40.74' 8" Pine
1978 - Delmar E. Porter	
Found 1½" Pipe	
N36°W 47.00' 12" Pine	
S69°W 49.68' 8" Pine	
S37°E 40.74' 8" Pine	


B. Description of corner evidence found and/or method applied in restoring or reestablishing corner:

G-13
Found concrete monument with brass cap lettered "Presque Isle County Remonumentation Monument"
N37°W 47.15' 16" Norway
found foot blaze
S68°W 49.59' 13" Norway
found foot blaze

SURVEY &
REMONUMENTATION

SEP 09 1994

COMMISSION

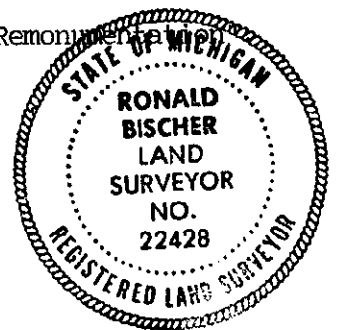

C. Description of monument for corner and accessories established to perpetuate locating the position of the corner:

G-13
Presque Isle County Remonumentation Monument
N37°W 47.15' 16" Norway
S68°W 49.59' 13" Norway
S56°E 87.92' 12" Norway
N80°E 56.48' 7" J. Pine

Ratified by Peer Group
in accordance with P.A. 945

Chairman *Delmar E. Porter*

Date July 27, 1994

*Witness tags w/nails used.

Signed by Ronald R. Bischer

Date July 20, 1994

Surveyor's Michigan License No. 22428