

SURVEY & REMONUMENTATION

1995 STATE OF MICHIGAN REMONUMENTATION

JAN 17 1996

PRESQUE ISLE COUNTY
RECORDED

2657

COMMISSION LAND CORNER RECORDATION CERTIFICATE

Filing Requirement of Act 74, Mich. P.A. 1970

55 DEC 14 11:10:29

For corners in

Presque Isle Located In: _____
(County)

Corner Code #

Janet M. Lamb
REGISTER OF DEEDS

- 1. Public Land Survey T 36N 2E R H3
- T _____ R _____
- T _____ R _____
- T _____ R _____
- 2. Property Controlling S _____ T _____ R _____
- in Section S _____ T _____ R _____
- 3. Miscellaneous S _____ T _____ R _____
- Property in Sec. S _____ T _____ R _____

LIBER **316** PAGE **944**

Register of Deeds Stamp & File Number

- 4. Lot No. _____, Recorded Plat _____
- 5. Private Claims _____

	A	B	C	D	E	F	G	H	I	J	K	L	M
2	6		5		4		3		2		1		
3								⊙					
4	7		8		9		10		11		12		
5													
6	18		17		16		15		14		13		
7													
8	19		20		21		22		23		24		
9													
10	30		29		28		27		26		25		
11													
12	31		32		33		34		35		36		
13													

I, James A. Beck in a field survey on NOV. 2, 19 95, do hereby certify that under requirements of P.A. 74, Michigan P.A. of 1970, the corner points mentioned in lines 1 and 2 above were in conformance with regulations and rules therefore as required in the current manual of survey instructions of the United States Department of the Interior, Bureau of Land Management or by a decree of a Court of Law and/or that the corner points mentioned in lines 3, 4 and 5 above were in conformance with the rules of the Michigan Board of Land Surveyors or by a Decree of a Court of Law; established, re-established, monumented, re-monumented, recovered, found as expressed below:

NOTE: Not more than 4 corners, all in the same town and range, may be recorded on this certificate.


A. Description of original monument and accessories and/or subsequent restoration:

H3 1856: Set post and referenced:
 Government Resurvey Aspen 16" N51 1/2°W 22 Links
 *by Geo. H. Cannon Cedar 6" S39°E 22 Links

April 1, 1968: Steel stake at corner. Painted
 ABT Company memo South line of Section.
 by Lyle W. Barden.

B. Description of corner evidence found and/or method applied in restoring or reestablishing corner:

H3 November 2, 1995 Found 1-1/2" pipe projecting 10"
 Remonumentation by Set 1/2" iron rod with P.S. 21559 cap in pipe
 James A. Beck
 P.S. 21559

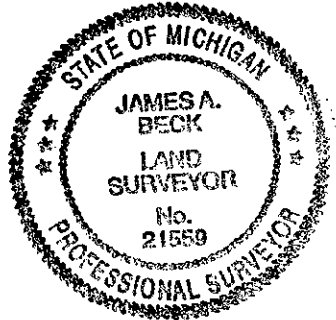

C. Description of monument for corner and accessories established to perpetuate locating the position of the corner:

H3 Found 1-1/2" pipe projecting 10"
 Set 1/2" iron rod with P.S. 21559 cap in pipe

Witnesses:

- N 89°W 24.87', 12" Maple
- S 10°W 11.04', 8" Cedar
- S 63°E 8.85', 7" Cedar
- N 3°E 23.63', 12" Maple

P.S. 21559 Witness tags set in trees

Ratified by Peer Group in accordance with P.A. 345

Chairman *Salvatore*
Date 11/1/95

Signed by *James A. Beck*
Surveyor's Michigan License No. 21559

Date 11-28-1995