

1995 STATE OF MICHIGAN REMONUMENTATION

COMMISSION

LAND CORNER RECORDATION CERTIFICATE
Filing Requirement of Act 74, Mich. P.A. 1970

PRESQUE ISLE COUNTY
RECORDED

95 DEC 14 AM 10:29

For corners in

Presque Isle Located In: Corner Code #
(County)

1. Public Land Survey	T	<u>36N</u>	<u>2E</u>	<u>H7</u>
	T	_____	_____	_____
	T	_____	_____	_____
	T	_____	_____	_____
2. Property Controlling in Section	S	_____	_____	_____
	S	_____	_____	_____
3. Miscellaneous Property in Sec.	S	_____	_____	_____
	S	_____	_____	_____

James M. Lamb
REGISTER OF DEEDS

LIBER **316** PAGE **945**

Register of Deeds Stamp & File Number

4. Lot No. _____, Recorded Plat _____
5. Private Claims _____

	A	B	C	D	E	F	G	H	I	J	K	L	M
2	6	5	4	3	2	1							
3													
4	7	8	9	10	11	12							
5													
6	18	17	16	15	14	13							
7													
8	19	20	21	22	23	24							
9													
10	30	29	28	27	26	25							
11													
12	31	32	33	34	35	36							
13													

I, James A. Beck in a field survey on May 17, 1995, do hereby certify that under requirements of P.A. 74, Michigan P.A. of 1970, the corner points mentioned in lines 1 and 2 above were in conformance with regulations and rules therefore as required in the current manual of survey instructions of the United States Department of the Interior, Bureau of Land Management or by a decree of a Court of Law and/or that the corner points mentioned in lines 3, 4 and 5 above were in conformance with the rules of the Michigan Board of Land Surveyors or by a Decree of a Court of Law; established, re-established, monumented, re-monumented, recovered, found as expressed below:

NOTE: Not more than 4 corners, all in the same town and range, may be recorded on this certificate.

A. Description of original monument and accessories and/or subsequent restoration:


H7	1856: Government Resurvey * by Geo. H. Cannon Set post and referenced: S. Pine 9" S47 1/2°E 36 1/2 Links Y. Pine 1" N20°W 10 Links	Sept. 22, 1976: Corner recorded by Ronald Bischer, P.S. 22428. Found "T" iron previously set by Delameter. Referenced: N27°E 87.82 20" N. Pine S59°W 61.92 Power Pole S33°W 44.32 9" Cedar	Set found "T" iron in monument box. Referenced: Sept. 29, 1978: Corner recorded by N27°E 87.82 20" N. Pine Delmer E. Porter, S59°W 61.92 Power Pole P.S. 15410. S33°W 44.32 9" Cedar

B. Description of corner evidence found and/or method applied in restoring or reestablishing corner:

H7 May 17, 1995: Remonumentation by James A. Beck, P.S. 21559. Ratified by Peer Group in accordance with P.A. 345 Chairman <i>Delmer E. Porter</i> Date <u>11/21/95</u>	Found 1/2" iron rod and cap (Delmer Porter, P.S. 15410) in monument box falling in centerline of paved road running East-West and centerline of gravel two-track road running South. Found 3 previous witnesses: old: N27°E 87.82 20" Pine Stump old: S59°W 61.86 Power Pole (tag #22428, Ronald Bischer) old: S33°W 44.40 12" Cedar (set tag P.S. 21559)
--	--

C. Description of monument for corner and accessories established to perpetuate locating the position of the corner:

H7 1/2" iron rod and cap (Delmer Porter,
P.S. 15410) in monument box
Witnesses:
old: N27°E 87.82 20" Pine Stump
old: S59°W 61.86 Power Pole (tag #22428, Ronald Bischer)
old: S33°W 44.40 12" Cedar (set tag P.S. 21559)
new: N10°W 43.08 8" Oak (set tag P.S. 21559)
new: N61°E 70.46 6" Balsam (set tag P.S. 21559)

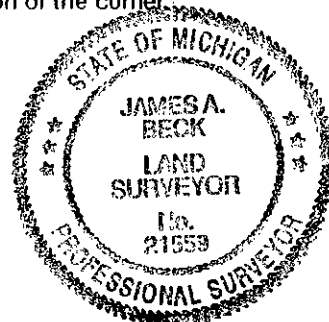

Signed by *James A. Beck* Date 11-28-1995
Surveyor's Michigan License No. 21559