

**LAND CORNER RECORDATION CERTIFICATE**  
**Filing Requirement of Act 74, Mich. P.A. 1970**

94 SEP 12 AM 10:41

For corners in

<u>Presque Isle</u> (County)	Located In:	Corner Code #
1. Public Land Survey	T <u>36N</u> R <u>2E</u>	<u>H-9</u>
	T _____ R _____	_____
	T _____ R _____	_____
	T _____ R _____	_____
2. Property Controlling in Section	S _____ T _____ R _____	_____
	S _____ T _____ R _____	_____
3. Miscellaneous Property in Sec.	S _____ T _____ R _____	_____
	S _____ T _____ R _____	_____

*Janet M. Lamb*  
 REGISTER OF DEEDS

LIBER **311** PAGE **247**

Register of Deeds Stamp & File Number

4. Lot No. \_\_\_\_\_, Recorded Plat \_\_\_\_\_  
 5. Private Claims \_\_\_\_\_

	A	B	C	D	E	F	G	H	I	J	K	L	M
2	6	5	4	3	2	1							
3													
4	7	8	9	10	11	12							
5													
6	18	17	16	15	14	13							
7													
8	19	20	21	22	23	24							
9													
10	30	29	28	27	26	25							
11													
12	31	32	33	34	35	36							
13													

I, James A. Beck, in a field survey on June 22, 1994, do hereby certify that under requirements of P.A. 74, Michigan P.A. of 1970, the corner points mentioned in lines 1 and 2 above were in conformance with regulations and rules therefore as required in the current manual of survey instructions of the United States Department of the Interior, Bureau of Land Management or by a decree of a Court of Law and/or that the corner points mentioned in lines 3, 4 and 5 above were in conformance with the rules of the Michigan Board of Land Surveyors or by a Decree of a Court of Law; established, re-established, monumented, re-monumented, recovered, found as expressed below:

**NOTE: Not more than 4 corners, all in the same town and range, may be recorded on this certificate.**

A. Description of original monument and accessories and/or subsequent restoration:

H-9  
 1856: Original monumentation in Government Resurvey. Set post at quarter section and referenced:  
 Cedar 8" N45°E 45 Links  
 Aspen 15" S50°W 7 Links

B. Description of corner evidence found and/or method applied in restoring or reestablishing corner:

H-9  
 1994: Found 3/4" pipe and two witnesses as recorded by Ronald R. Bischer, P.S. 22428 (recorded March 9, 1984, Presque Isle County Records).  
 Witnesses found (as recorded):  
 S27°W 16.36' 5" Balsam  
 S43°E 32.38' 3" Black Ash


Ratified by Peer Group  
 in accordance with P.A. 345

Chairman *Delmer E. Porter*  
 Date August 29, 1994

C. Description of monument for corner and accessories established to perpetuate locating the position of the corner:

H-9  
 1994: 3/4" pipe and cap P.S. 21559 in wooded area at center of old Northerly and Easterly trails extended.  
 Witnesses:  
 S27°W (r) 16.36' (m) 16.40' 8" Balsam (P.R.)\*  
 S43°E 32.38' 6" Black Ash (P.R.)\*  
 S63°E 42.30' 5" White Birch\*  
 S05°E 21.98' 4" Black Ash\*  
 N22°W 54.12' 4" Maple\*  
 S85°W 0.80' 5" Maple\*

P. R. = Previously Recorded  
 \* = Set tag P.S. 21559

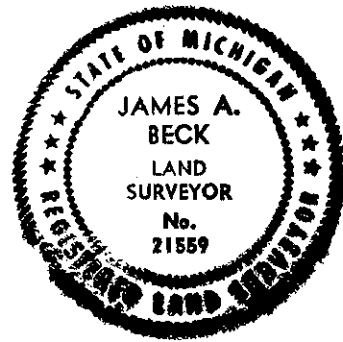

Signed by *James A. Beck* Date August 25, 1994  
 Surveyor's Michigan License No. 21559

2459