

State of Michigan Remonumentation Program  
For Presque Isle County

PRESQUE ISLE COUNTY  
RECORDED

94 AUG 23 AM 10:11

LAND CORNER RECORDATION CERTIFICATE  
Filing Requirement of Act 74, Mich. P.A. 1970

For corners in

<u>PRESQUE ISLE</u> <small>(County)</small>	Located In:	Corner Code #
1. Public Land Survey	T <u>36N</u> R <u>2E</u>	<u>H-13</u>
	T _____ R _____	_____
	T _____ R _____	_____
	T _____ R _____	_____
2. Property Controlling in Section	S _____ T _____ R _____	_____
	S _____ T _____ R _____	_____
3. Miscellaneous Property in Sec.	S _____ T _____ R _____	_____
	S _____ T _____ R _____	_____

*Janet M. Lamb*  
REGISTER OF DEEDS

LIBER **310** PAGE **936**

Register of Deeds Stamp & File Number

4. Lot No. \_\_\_\_\_, Recorded Plat \_\_\_\_\_  
5. Private Claims \_\_\_\_\_

	A	B	C	D	E	F	G	H	I	J	K	L	M
2	6	5	4	3	2	1							
3													
4	7	8	9	10	11	12							
5													
6	18	17	16	15	14	13							
7													
8	19	20	21	22	23	24							
9													
10	30	29	28	27	26	25							
11													
12	31	32	33	34	35	36							

I, Ronald Bischer, in a field survey on April 6, 19 94, do hereby certify that under requirements of P.A. 74, Michigan P.A. of 1970, the corner points mentioned in lines 1 and 2 above were in conformance with regulations and rules therefore as required in the current manual of survey instructions of the United States Department of the Interior, Bureau of Land Management or by a decree of a Court of Law and/or that the corner points mentioned in lines 3, 4 and 5 above were in conformance with the rules of the Michigan Board of Land Surveyors or by a Decree of a Court of Law; established, re-established, monumented, re-monumented, recovered, found as expressed below:


**NOTE: Not more than 4 corners, all in the same town and range, may be recorded on this certificate.**

A. Description of original monument and accessories and/or subsequent restoration:

H-13  
GLO Notes, Resurvey 1856  
Set Wood Post  
Pine 12" N65°E 20 links  
Pine 8" N68°W 57 links

B. Description of corner evidence found and/or method applied in restoring or reestablishing corner:

H-13  
Set 1/2" Rod and Cap #22428 by single proportion.

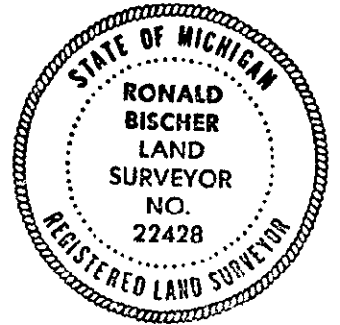

SURVEY &  
REMONUMENTATION

SEP 09 1994

COMMISSION

C. Description of monument for corner and accessories established to perpetuate locating the position of the corner:

H-13  
1/2" Rod and Cap #22428  
S68°E 83.34' 6" J. Pine  
N83°E 45.12' 9" J. Pine  
N65°E 22.64' 10" J. Pine  
N26°W 21.44' 8" J. Pine

Ratified by Peer Group  
in accordance with P.A. 345  
Chairman *Delmer E. Pater*  
Date July 27, 1994

\*Witness tags and nails used.

Signed by Ronald R. Bischer Date July 20, 1994  
Surveyor's Michigan License No. 22428