

1995 ~~1996~~ JAN 17 1996 PRESQUE ISLE COUNTY, STATE OF MICHIGAN REMONUMENTATION

2228

COMMISSION LAND CORNER RECORDATION CERTIFICATE  
Filing Requirement of Act 74, Mich. P.A. 1970

LIBER 316 PAGE 311  
PRESQUE ISLE COUNTY  
RECORDED

95 OCT 20 PM 4:33

*Janet M. Lamb*  
REGISTER OF DEEDS

Register of Deeds Stamp & File Number

For corners in

<u>PRESQUE ISLE</u> (County)	Located In:	Corner Code //
1. Public Land Survey	T <u>36N</u> R <u>2E</u>	<u>I-5</u>
	T _____ R _____	_____
	T _____ R _____	_____
	T _____ R _____	_____
2. Property Controlling in Section	S _____ T _____ R _____	_____
	S _____ T _____ R _____	_____
3. Miscellaneous Property in Sec.	S _____ T _____ R _____	_____
	S _____ T _____ R _____	_____

4. Lot No. \_\_\_\_\_, Recorded Plat \_\_\_\_\_  
5. Private Claims \_\_\_\_\_

A	B	C	D	E	F	G	H	I	J	K	L	M
2	6	5	4	3	2	1						
3												
4	7	8	9	10	11	12						
5												
6	18	17	16	15	14	13						
7												
8	19	20	21	22	23	24						
9												
10	30	29	28	27	26	25						
11												
12	31	32	33	34	35	36						
13												

I, Ronald Bischer, in a field survey on March 3, 19 95, do hereby certify that under requirements of P.A. 74, Michigan P.A. of 1970, the corner points mentioned in lines 1 and 2 above were in conformance with regulations and rules therefore as required in the current manual of survey instructions of the United States Department of the Interior, Bureau of Land Management or by a decree of a Court of Law and/or that the corner points mentioned in lines 3, 4 and 5 above were in conformance with the rules of the Michigan Board of Land Surveyors or by a Decree of a Court of Law, established, re-established, monumented, re-monumented, recovered, found as expressed below:

NOTE: Not more than 4 corners, all in the same town and range, may be recorded on this certificate.


A. Description of original monument and accessories and/or subsequent restoration:

GLO Notes - 1856 Resurvey	S51°E 32.90'	8" Black Ash
Geo. H. Cannon	N22°W 33.88'	26" Aspen
Set wood post	S39°W 41.10'	16" Cedar
Tamarack 9" N60°W 19 lks		
Tamarack 11" N56°E 34 lks		
05-19-77 - Ronald R. Bischer	11-06-78 - Delmar E. Porter	
Found 1½" Bar in fire lane intersection (Dave Green)	Replaced 1½" Bar with Conc. mon. w/brass cap	
N36°E 36.30' 12" Cedar	Witnesses same as 05-19-77 (R. Bischer)	

B. Description of corner evidence found and/or method applied in restoring or reestablishing corner:

Found Presque Isle County Remonumentation Monument  
(conc. mon. with brass cap)

N36°E 36.30'	12" Cedar
S51°E 32.90'	8" Black Ash
N22°W 33.88'	26" Aspen
S39°W 41.10'	16" Cedar - blown over

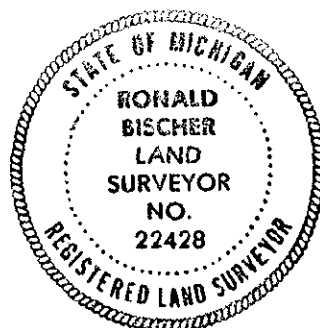

C. Description of monument for corner and accessories established to perpetuate locating the position of the corner:

Presque Isle County Remonumentation Monument

N36°E 36.30'	12" Cedar
S51°E 32.90'	8" Black Ash
N22°W 33.88'	26" Aspen
S29°W 57.10'	16" Cedar

Ratified by Peer Group  
in accordance with P.A. 345  
Chairman *Delmar E. Porter*  
Date 9/20/95

Nails with witness tag #22428 used.

Signed by Ronald R. Bischer Date Oct. 3, 1995  
Surveyor's Michigan License No. 22428