

PRESQUE ISLE COUNTY
RECORDED

LAND CORNER RECORDATION CERTIFICATE
Filing Requirement of Act 74, Mich. P.A. 1970

94 SEP 12 AM 10:41

For corners in

Presque Isle (County) Located In: Corner Code #

1. Public Land Survey T 36N R 2E 1-7
 T _____ R _____
 T _____ R _____
 T _____ R _____

2. Property Controlling S _____ T _____ R _____
 in Section S _____ T _____ R _____

3. Miscellaneous S _____ T _____ R _____
 Property in Sec. S _____ T _____ R _____

Janet M. Lamb
REGISTER OF DEEDS

LIBER **311** PAGE **246**

Register of Deeds Stamp & File Number

4. Lot No. _____, Recorded Plat _____
 5. Private Claims _____

| | A | B | C | D | E | F | G | H | I | J | K | L | M |
|----|----|----|----|----|----|----|---|---|---|---|---|---|---|
| 2 | 6 | 5 | 4 | 3 | 2 | 1 | | | | | | | |
| 3 | | | | | | | | | | | | | |
| 4 | 7 | 8 | 9 | 10 | 11 | 12 | | | | | | | |
| 5 | | | | | | | | | | | | | |
| 6 | 13 | 17 | 16 | 15 | 14 | 13 | | | | | | | |
| 7 | | | | | | | | | | | | | |
| 8 | 19 | 20 | 21 | 22 | 23 | 24 | | | | | | | |
| 9 | | | | | | | | | | | | | |
| 10 | 30 | 29 | 28 | 27 | 26 | 25 | | | | | | | |
| 11 | | | | | | | | | | | | | |
| 12 | 31 | 32 | 33 | 34 | 35 | 36 | | | | | | | |
| 13 | | | | | | | | | | | | | |

I, James A. Beck, in a field survey on March 7, 1994, do hereby certify that under requirements of P.A. 74, Michigan P.A. of 1970, the corner points mentioned in lines 1 and 2 above were in conformance with regulations and rules therefore as required in the current manual of survey instructions of the United States Department of the Interior, Bureau of Land Management or by a decree of a Court of Law and/or that the corner points mentioned in lines 3, 4 and 5 above were in conformance with the rules of the Michigan Board of Land Surveyors or by a Decree of a Court of Law; established, re-established, monumented, re-monumented, recovered, found as expressed below:

NOTE: Not more than 4 corners, all in the same town and range, may be recorded on this certificate.


A. Description of original monument and accessories and/or subsequent restoration:

- 1-7
 1856: Original monumentation in Government Resurvey. Set post at corner of Sections 14, 15, 22, and 23 and referenced:
 Tamarack 9" S30°W 27 Links
 Y Pine 14" N30°W 27 Links
- 1978: Delmer E. Porter, P.S. 15410, placed 1/2" rod in monument box (from Corner Card furnished by Porter's Survey). Referenced:
 N39°E 62.31' 6" Cedar
 N55°E 51.79' 6" Cedar
 S61°E 84.94' T. Pole

B. Description of corner evidence found and/or method applied in restoring or reestablishing corner:

- 1-7
 1994: Found a 1/2" iron rod in monument box and one witness as documented by Delmer E. Porter (see above). Witness found (as recorded):
 N55°E 51.79' 6" Cedar

Ratified by Peer Group
 in accordance with P.A. 345
 Chairman Delmer E. Porter
 Date August 29, 1994

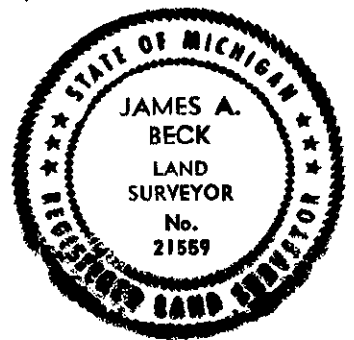

C. Description of monument for corner and accessories established to perpetuate locating the position of the corner:

- 1-7
 1994: 1/2" iron rod and cap P.S. 21559 in monument box in centerline of 2-track road running North, centerline of driveway running Southerly, and 3' Northerly of East-West blacktop road centerline.
 Witnesses:
 N55°E (r) 51.79' (m) 51.80' 8" Cedar (P.R., tag 21559)
 S15°W 47.02' NE Face 4" Steel Gate Post
 S58°E 83.55' NE Corner Underground Telephone Junction Box
 N54°W 64.38' 9" White Pine (tag 21559)
 S13°E 40.81' 7" Spruce (tag 21559)

P. R. = Previously Recorded

Signed by James A. Beck Date August 25, 1994
 Surveyor's Michigan License No. 21559