

LAND CORNER RECORDATION CERTIFICATE
Filing Requirement of Act 74, Mich. P.A. 1970

94 SEP 12 AM 10:41

For corners in

<u>Presque Isle</u> (County)	Located In:	Corner Code #
1. Public Land Survey	T <u>36N</u> R <u>2E</u>	<u>1-8</u>
	T _____ R _____	_____
	T _____ R _____	_____
	T _____ R _____	_____
2. Property Controlling in Section	S _____ T _____ R _____	_____
	S _____ T _____ R _____	_____
3. Miscellaneous Property in Sec.	S _____ T _____ R _____	_____
	S _____ T _____ R _____	_____
4. Lot No. _____, Recorded Plat _____		
5. Private Claims _____		

Janet M. Lamb
REGISTER OF DEEDS

LIBER **311** PAGE **245**

Register of Deeds Stamp & File Number

I, James A. Beck, in a field survey on July 29, 19 94, do hereby certify that under requirements of P.A. 74, Michigan P.A. of 1970, the corner points mentioned in lines 1 and 2 above were in conformance with regulations and rules therefore as required in the current manual of survey instructions of the United States Department of the Interior, Bureau of Land Management or by a decree of a Court of Law and/or that the corner points mentioned in lines 3, 4 and 5 above were in conformance with the rules of the Michigan Board of Land Surveyors or by a Decree of a Court of Law; established, re-established, monumented, re-monumented, recovered, found as expressed below:

A	B	C	D	E	F	G	H	I	J	K	L	M
2	6	5	4	3	2	1						
3												
4	7	8	9	10	11	12						
5												
6	18	17	16	15	14	13						
7												
8	19	20	21	22	23	24						
9												
10	30	29	28	27	26	25						
11												
12	31	32	33	34	35	36						

NOTE: Not more than 4 corners, all in the same town and range, may be recorded on this certificate.


A. Description of original monument and accessories and/or subsequent restoration:

1-8
 1856: Original monumentation in Government Resurvey.
 Set post at quarter corner and referenced:
 Y Pine 12" N30°W 12 1/2 Links
 Y Pine 12" N46°E 32 Links

Ratified by Peer Group
in accordance with P.A. 345
 Chairman Delmer E. Porter
 Date August 29, 1994

B. Description of corner evidence found and/or method applied in restoring or reestablishing corner:

1-8
 1994: Found a 1 1/2" galvanized pipe in rock cairn and four witnesses as documented by Delmer E. Porter, P. S. 15410 (recorded March 9, 1984, L. 252, P. 256, Presque Isle County Records).
 Witnesses found (as recorded):
 N26°W 37.00' 7" Maple
 N51°E 21.25' O. B. T. Stump
 S78°E 32.72' 5" Maple
 S33°E 50.75' 4" Cedar

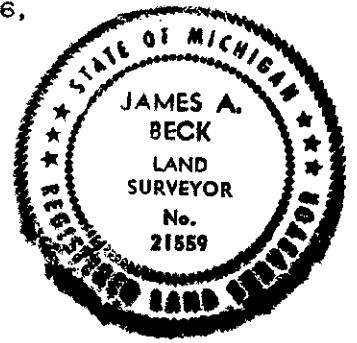

C. Description of monument for corner and accessories established to perpetuate locating the position of the corner:

1-8
 1994: 1 1/2" galvanized pipe in rock cairn in brushed line to North at approximate Southerly extension of a driveway to North.
 Witnesses:
 N26°W (r) 37.00' (m) 36.95' 8" Maple (P.R., tag 15410-Delmer E. Porter)
 N51°E (r) 21.25' (m) 21.2' O. B. T. Stump (P.R.)
 S78°E (r) 32.72' (m) 32.70' 6" Maple (P.R., tag 15410-Delmer E. Porter)
 S33°E (r) 50.75' (m) 50.8' 6" Cedar (P.R., tag 15410-Delmer E. Porter)
 North 45.27' 8" stem of triple Maple (tag 21559)
 P. R. = Previously Recorded

Signed by James A. Beck
 Surveyor's Michigan License No. 21559

Date August 25, 1994

2459