

PRESQUE ISLE COUNTY
RECORDED

94 SEP 12 AM 10:41

LAND CORNER RECORDATION CERTIFICATE
Filing Requirement of Act 74, Mich. P.A. 1970

For corners in

<u>Presque Isle</u> (County)	Located In:	Corner Code #
1. Public Land Survey	T <u>36N</u> R <u>2E</u>	<u>1-9</u>
	T _____ R _____	_____
	T _____ R _____	_____
	T _____ R _____	_____
2. Property Controlling in Section	S _____ T _____ R _____	_____
	S _____ T _____ R _____	_____
3. Miscellaneous Property in Sec.	S _____ T _____ R _____	_____
	S _____ T _____ R _____	_____

Janet M. Lamb
REGISTER OF DEEDS

LIBER **311** PAGE **244**

Register of Deeds Stamp & File Number

4. Lot No. _____, Recorded Plat _____
5. Private Claims _____

	A	B	C	D	E	F	G	H	I	J	K	L	M
2	6	5	4	3	2	1							
3													
4	7	8	9	10	11	12							
5													
6	18	17	16	15	14	13							
7													
8	19	20	21	22	23	24							
9													
10	30	29	28	27	26	25							
11													
12	31	32	33	34	35	36							
13													

I, James A. Beck, in a field survey on March 15, 19 94, do hereby certify that under requirements of P.A. 74, Michigan P.A. of 1970, the corner points mentioned in lines 1 and 2 above were in conformance with regulations and rules therefore as required in the current manual of survey instructions of the United States Department of the Interior, Bureau of Land Management or by a decree of a Court of Law and/or that the corner points mentioned in lines 3, 4 and 5 above were in conformance with the rules of the Michigan Board of Land Surveyors or by a Decree of a Court of Law; established, re-established, monumented, re-monumented, recovered, found as expressed below:

NOTE: Not more than 4 corners, all in the same town and range, may be recorded on this certificate.


A. Description of original monument and accessories and/or subsequent restoration:

1-9
1856: Original monumentation in Government Resurvey. Set post at corner of Sections 22, 23, 26 and 27 and referenced:
Spruce 12" N36°E 3 Links
Tamarack 8" S54°W 5 Links

B. Description of corner evidence found and/or method applied in restoring or reestablishing corner:

1-9
1994: Found 1/2" iron rod and three witnesses as recorded by Ronald R. Bischer, P.S. 22428 (corner recorded March 9, 1984, Presque Isle County Records).
Witnesses found (as recorded):
N25°W 24.83' 10" Cedar
N35°E 24.50' 6" Cedar
S77°W 46.13' 12" Cedar

Ratified by Peer Group in accordance with P.A. 345
Chairman Delmer E. Porter
Date August 29, 1994

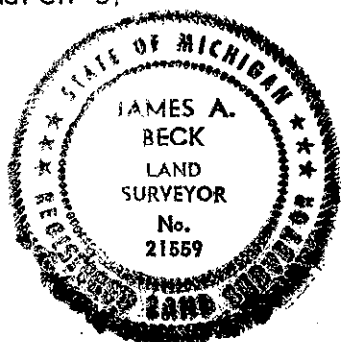

C. Description of monument for corner and accessories established to perpetuate locating the position of the corner:

1-9
1994: 1/2" iron rod and cap P.S. 21559 in center of East-West dirt road and on Westerly side of dirt road running South.
Witnesses:
N25°W 24.83' 12" Cedar stump (P.R., old blaze)
N35°E (r) 24.50' (m) 24.53' 8" Cedar (P.R.; tag 15410-Delmer E. Porter) *
S77°W (r) 46.13' (m) 46.15' 12" Cedar (P.R.; tag 15410-Delmer E. Porter) *
N30°W 24.91' 10" Cedar *
S28°E 55.70' 8" Maple *
S68°E 56.44' 9" Tamarack *
P.R. = Previously Recorded
* = set tag P.S. 21559

Signed by James A. Beck Date August 25, 1994
Surveyor's Michigan License No. 21559

2459