SURVEY & MONUMENTATION

1995 PRESQUE ISLE COUNTY, STATE OF MICHIGAN REMONUMENTATION

2232 JAN 17 1996

COMMISSION

LAND CORNER RECORDATION CERTIFICATE

Filing Requirement of Act 74, Mich. P.A. 1970

LIBER 316 PAGE 315
PRESQUE ISLE COUNTY
RECORDED

95 OCT 20 PM 4:34

REGISTER OF DEEDS

Register of Deeds Stamp & File Number

For corners in PRESQUE ISLE (County) Located In: Corner Code #

1. Public Land Survey T 36N R 2E J-7
   T ___ R ___
   T ___ R ___
   T ___ R ___
2. Property Controlling S ___ T ___ R ___
   in Section S ___ T ___ R ___
3. Miscellaneous S ___ T ___ R ___
   Property in Section S ___ T ___ R ___

4. Lot No. _____, Recorded Plat _____
5. Private Claims _____

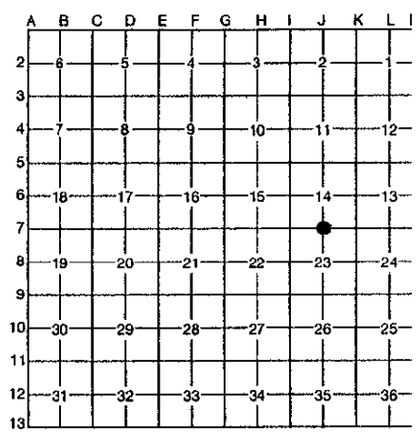

I, Ronald Bischer, in a field survey on July 26, 19 95, do hereby certify that under requirements of P.A. 74, Michigan P.A. of 1970, the corner points mentioned in lines 1 and 2 above were in conformance with regulations and rules therefore as required in the current manual of survey instructions of the United States Department of the Interior, Bureau of Land Management or by a decree of a Court of Law and/or that the corner points mentioned in lines 3, 4 and 5 above were in conformance with the rules of the Michigan Board of Professional Surveyors or by a Decree of a Court of Law; established, re-established, monumented, re-monumented, recovered, found as expressed below:

NOTE: Not more than 4 corners, all in the same town and range, may be recorded on this certificate.

A. Description of original monument and accessories and/or subsequent restoration:

1856 Resurvey - GLO Notes
Geo. H. Cannon
Set Wood Post
Hemlock 17" S43°E 30 lks
Hemlock 14" N68°W 7 lks

9-15-78 Delmar E. Porter #15410
Found 5/8" Rod, Set monument box
N19°E 43.49' 9" Balsam
S44°W 49.98' 20" Oak

S03°E 55.98' 7" Lynn

6-9-93 Delmar E. Porter
SQ. Headed Bolt
S75°30'E 77.94' 14" Maple
S51°30'W 48.97' 16" Oak
N26°30'E 43.48' 6" Spruce

B. Description of corner evidence found and/or method applied in restoring or reestablishing corner:

Found 5/8" Re-rod in Monument box, set Cap #22428
N16°E 43.49' 13" Balsam
S10°E 45.90' 9" Lynn
S41°W 48.92' 21" Maple

STATE OF MICHIGAN
RONALD BISCHER
LAND SURVEYOR
NO. 22428
REGISTERED LAND SURVEYOR

C. Description of monument for corner and accessories established to perpetuate locating the position of the corner:

5/8" Rod & Cap #22428 in Monument Box
N16°E 43.49' 13" Balsam
S10°E 45.90' 9" Lynn
S41°W 48.92' 21" Maple
N48°W 58.07' 6" Maple

Nails with witness tag #22428 used.

Ratified by Peer Group
in accordance with P.A. 345
Chairman Delmer E. Porter
Date 9/20/95

Signed by Ronald F. Bischer Date Oct 3, 1995

Surveyor's Michigan License No. 22428

FORM APPROVED BY MICHIGAN STATE BOARD OF PROFESSIONAL SURVEYORS, JAN. 28, 1971
REVISED MAY 14, 1975
REVISED JAN., 1983