

PRESQUE ISLE COUNTY REGISTERED

94 SEP 12 AM 10:41

LAND CORNER RECORDATION CERTIFICATE  
Filing Requirement of Act 74, Mich. P.A. 1970

For corners in

<u>Presque Isle</u> (County)	Located In:	Corner Code #
1. Public Land Survey	T <u>36N</u> R <u>2E</u>	<u>J-9</u>
	T _____ R _____	_____
	T _____ R _____	_____
	T _____ R _____	_____
2. Property Controlling in Section	S _____ T _____ R _____	_____
	S _____ T _____ R _____	_____
3. Miscellaneous Property in Sec.	S _____ T _____ R _____	_____
	S _____ T _____ R _____	_____

*Jana M. Lamb*  
REGISTER OF DEEDS

LIBER **311** PAGE **243**

Register of Deeds Stamp & File Number

- 4. Lot No. \_\_\_\_\_, Recorded Plat \_\_\_\_\_
- 5. Private Claims \_\_\_\_\_

A	B	C	D	E	F	G	H	I	J	K	L	M
2	6	5	4	3	2	1						
3												
4	7	8	9	10	11	12						
5												
6	18	17	16	15	14	13						
7												
8	19	20	21	22	23	24						
9												
10	30	29	28	27	26	25						
11												
12	31	32	33	34	35	36						
13												


I, James A. Beck, in a field survey on March 15, 19 94, do hereby certify that under requirements of P.A. 74, Michigan P.A. of 1970, the corner points mentioned in lines 1 and 2 above were in conformance with regulations and rules therefore as required in the current manual of survey instructions of the United States Department of the Interior, Bureau of Land Management or by a decree of a Court of Law and/or that the corner points mentioned in lines 3, 4 and 5 above were in conformance with the rules of the Michigan Board of Land Surveyors or by a Decree of a Court of Law; established, re-established, monumented, re-monumented, recovered, found as expressed below:

**NOTE: Not more than 4 corners, all in the same town and range, may be recorded on this certificate.**

- A. Description of original monument and accessories and/or subsequent restoration:
- J-9
  - 1856: Original monumentation in Government Resurvey. Set post at quarter corner and referenced:  
W Pine 14" N85°W 36 Links  
W Birch 12" S17°W 28 Links
  - 1983: Ronald R. Bischer, P.S. 22428, set 1/2" rod by single proportion. (Corner recorded March 9, 1984, Presque Isle County Records.) Referenced:  
N46°W 41.52' 8" Tamarack  
N64°E 40.27' 5" Maple  
S72°W 68.22' 8" Maple

- B. Description of corner evidence found and/or method applied in restoring or reestablishing corner:
- J-9
  - 1994: Found 1/2" iron rod and cap P.S. 15410. Found two witnesses as recorded by Ronald R. Bischer, P.S. 22428 (see above). Witnesses found (as recorded):  
N46°W 41.52' 8" Tamarack  
N64°E 40.27' 5" Maple

Ratified by Peer Group  
in accordance with P.A. 345  
Chairman *Delmer E. Porter*  
Date August 29, 1994

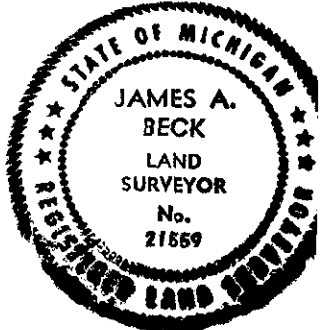

- C. Description of monument for corner and accessories established to perpetuate locating the position of the corner:
- J-9
  - 1994: 1/2" iron rod and cap P.S. 15410 (Delmer E. Porter) at Northerly edge of dirt roadway with a blazed line to the North.  
Witnesses:  
N46°W (r) 41.52' (m) 41.58' 14" Tamarack (P.R., old blaze) \*  
N64°E (r) 40.27' (m) 40.23' 10" Maple (P.R., old blaze) \*  
S29°W 20.37' 10" Balsam \*  
S40°E 53.43' 9" White Pine \*
- P.R. = Previously Recorded  
\* = Set tag P.S. 21559

Signed by *James A. Beck*  
Surveyor's Michigan License No. 21559

Date August 25, 1994