

LAND CORNER RECORDATION CERTIFICATE, AUG 23 AM 10:11
Filing Requirement of Act 74, Mich. P.A. 1970

For corners in

<u>PRESQUE ISLE</u> (County)	Located In:	Corner Code #
1. Public Land Survey	T <u>36N</u> R <u>2E</u>	<u>J-11</u>
	T _____ R _____	_____
	T _____ R _____	_____
	T _____ R _____	_____
2. Property Controlling in Section	S _____ T _____ R _____	_____
	S _____ T _____ R _____	_____
3. Miscellaneous Property in Sec.	S _____ T _____ R _____	_____
	S _____ T _____ R _____	_____
4. Lot No. _____, Recorded Plat _____		
5. Private Claims _____		

Janet M. Lamb
REGISTER OF DEEDS

LIBER **310** PAGE **933**

Register of Deeds Stamp & File Number


I, Ronald Bischer, in a field survey on April 7, 19 94, do hereby certify that under requirements of P.A. 74, Michigan P.A. of 1970, the corner points mentioned in lines 1 and 2 above were in conformance with regulations and rules therefore as required in the current manual of survey instructions of the United States Department of the Interior, Bureau of Land Management or by a decree of a Court of Law and/or that the corner points mentioned in lines 3, 4 and 5 above were in conformance with the rules of the Michigan Board of Land Surveyors or by a Decree of a Court of Law; established, re-established, monumented, re-monumented, recovered, found as expressed below:

NOTE: Not more than 4 corners, all in the same town and range, may be recorded on this certificate.

	A	B	C	D	E	F	G	H	I	J	K	L	M
2	6		5		4		3		2		1		
3													
4	7		8		9		10		11		12		
5													
6	18		17		16		15		14		13		
7													
8	19		20		21		22		23		24		
9													
10	30		29		28		27		26		25		
11													
12	31		32		33		34		35		36		
13													

A. Description of original monument and accessories and/or subsequent restoration:

J-11
GLO Notes, Resurvey 1856
Set Wood Post
Tamarac 7" 64½°E 13 links
Tamarac 9" S02°W 13½ links

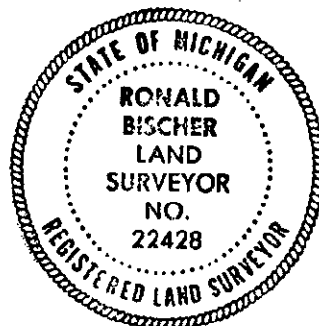

B. Description of corner evidence found and/or method applied in restoring or reestablishing corner:

J-11
Set ½" Rod and Cap #22428 by single proportion, in old grown-over fire lane.

SURVEY &
REMONUMENTATION

SEP 09 1994

COMMISSION

C. Description of monument for corner and accessories established to perpetuate locating the position of the corner:

J-11
½" Rod and Cap #22428
N65°E 40.30' 11" Cedar
S07°E 27.88' 20" Cedar
S52°W 34.95' 10" Cedar
N59°W 25.55' 6" Cedar

Ratified by Peer Group
in accordance with P.A. 345

Chairman *Delmire E. Patu*

Date July 27, 1994

*Witness tags w/nails used.

Signed by Ronald R. Bischer

Date July 20, 1994

Surveyor's Michigan License No. 22428