

SURVEY & REMONUMENTATION
 1995 PRESQUE ISLE COUNTY, STATE OF MICHIGAN REMONUMENTATION

2221

JAN 17 1996

COMMISSION
LAND CORNER RECORDATION CERTIFICATE
 Filing Requirement of Act 74, Mich. P.A. 1970

LIBER **316** PAGE **304**

For corners in PRESQUE ISLE (County) Located In: _____ Corner Code # _____

1. Public Land Survey	T	<u>36</u> NR	<u>2E</u>	<u>K-4</u>
	T	_____	R _____	_____
	T	_____	R _____	_____
	T	_____	R _____	_____
2. Property Controlling in Section	S	_____	T _____	R _____
	S	_____	T _____	R _____
3. Miscellaneous Property in Section	S	_____	T _____	R _____
	S	_____	T _____	R _____

4. Lot No. _____, Recorded Plat _____

5. Private Claims _____

PRESQUE ISLE COUNTY
 RECORDED

95 OCT 20 PM 4: 31

Janet M. Lamb
 REGISTER OF DEEDS

Register of Deeds Stamp & File Number

I, Ronald Bischer, in a field survey on July 26, 1995 do hereby certify that under requirements of P.A. 74, Michigan P.A. of 1970, the corner points mentioned in lines 1 and 2 above were in conformance with regulations and rules therefore as required in the current manual of survey instructions of the United States Department of the Interior, Bureau of Land Management or by a decree of a Court of Law and/or that the corner points mentioned in lines 3, 4 and 5 above were in conformance with the rules of the Michigan Board of Professional Surveyors or by a Decree of a Court of Law; established, re-established, monumented, re-monumented, recovered, found as expressed below:

NOTE: Not more than 4 corners, all in the same town and range, may be recorded on this certificate.


A	B	C	D	E	F	G	H	I	J	K	L	M
2	6	5	4	3	2	1						
3												
4	7	6	9	10	11	12						
5												
6	18	17	16	15	14	13						
7												
8	19	20	21	22	23	24						
9												
10	30	29	28	27	26	25						
11												
12	31	32	33	34	35	36						
13												

A. Description of original monument and accessories and/or subsequent restoration:

1856 Resurvey - GLO Notes	N49°E 67.45'	7" Birch	11-6-78 D. E. Porter
Geo. H. Cannon	S53°E 36.35'	3" Spruce	Found 5/8" Rod, replaced with Conc. Mon. w/Brass cap - sam wit. as in 2-4-75.
Set Wood Post	N49°E 67.64'	9" Birch	
Beech 7" S60°E 29½ lks	S53°E 36.31'	6" Spruce	
Maple 12" N58°W 45 lks	N18°W 59.98'	8" Oak	
2-6-75 Delmar E. Porter	2-4-75 Delmar E. Porter	5-3-84, 4-21-87	
#15410 - Found 5/8" Rod set by Doyle	5/8" Rod	Delmar E. Porter	
N18°W 60.05' 6" Oak	N18°W 59.98' 8" Oak	Concrete Monument with Brass Cap - wit same as in 2-4-75.	
	N49°E 67.64' 9" Birch		
	S53°E 36.31' 6" Spruce		

B. Description of corner evidence found and/or method applied in restoring or reestablishing corner:

Found Presque Isle County Remonumentation Monument (conc. mon. w/brass cap)
 N68°E 87.09' 12" Cedar
 S46°E 72.41' 8" Maple

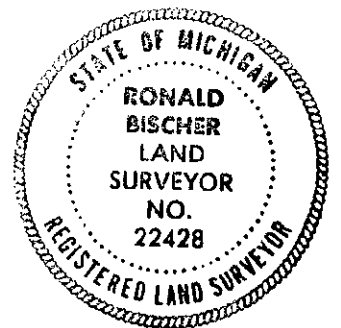

C. Description of monument for corner and accessories established to perpetuate locating the position of the corner:

Presque Isle County Remonumentation monument
 N68°E 87.09' 12" Cedar
 S46°E 72.41' 8" Maple
 S24°W 75.95' 6" Spruce
 N37°W 60.43' 5" Balsam

Nails with witness tag #22428 used.

Ratified by Peer Group in accordance with P.A. 345
 Chairman *Richard E. Porter*
 Date 9/20/95

Signed by *Ronald R. Bischer*
 Surveyor's Michigan License No. 22428

Date Oct. 3, 1995