

SURVEY &
RECORDATION
1995 PRESQUE ISLE COUNTY, STATE OF MICHIGAN REMONUMENTATION

2220

JAN 17 1996

LAND CORNER RECORDATION CERTIFICATE

COMMISSION Filing Requirement of Act 74, Mich. P.A. 1970

PRESQUE ISLE COUNTY
RECORDED

For corners in
PRESQUE ISLE
(County)

Located In:

Corner Code #

95 OCT 20 PM 4:31

Jane M. Lambert
REGISTER OF DEEDS


LIBER **316** PAGE **305**

Register of Deeds Stamp & File Number

- | | | |
|--------------------------------------|--------------------------|------------|
| 1. Public Land Survey | T <u>36N</u> R <u>2E</u> | <u>K-5</u> |
| | T _____ R _____ | _____ |
| | T _____ R _____ | _____ |
| | T _____ R _____ | _____ |
| 2. Property Controlling in Section | S _____ T _____ R _____ | _____ |
| | S _____ T _____ R _____ | _____ |
| 3. Miscellaneous Property in Section | S _____ T _____ R _____ | _____ |
| | S _____ T _____ R _____ | _____ |

4. Lot No. _____, Recorded Plat _____
5. Private Claims _____

I, Ronald Bischer, in a field survey on July 27, 1995, do hereby certify that under requirements of P.A. 74, Michigan P.A. of 1970, the corner points mentioned in lines 1 and 2 above were in conformance with regulations and rules therefore as required in the current manual of survey instructions of the United States Department of the Interior, Bureau of Land Management or by a decree of a Court of Law and/or that the corner points mentioned in lines 3, 4 and 5 above were in conformance with the rules of the Michigan Board of Professional Surveyors or by a Decree of a Court of Law; established, re-established, monumented, re-monumented, recovered, found as expressed below:

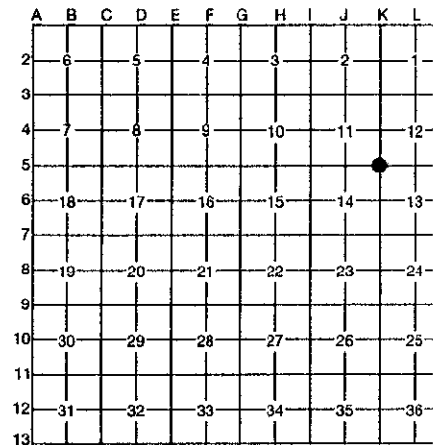


NOTE: Not more than 4 corners, all in the same town and range, may be recorded on this certificate.

A. Description of original monument and accessories and/or subsequent restoration:

- | | | |
|--------------------------------|---|-------------|
| 1856 Resurvey - GLO notes | S40°E 61.51' | 24" Spruce |
| Geo. H. Cannon | S10°W 56.45' | 11" Balsam |
| Set Wood Post | S65°W 58.41' | 14" J. Pine |
| Tamarack 10" S64½°E 100 lks | 4-21-87 Delmar E. Porter | |
| Y. Pine 16" S76°W 81 lks | ½" Rod and Cap | |
| 2-6-75 Delmar E. Porter #15410 | same witnesses as 2-6-75 | |
| Found 2" Pipe | 10-19-87 Delmar E. Porter | |
| S40°E 61.45' 12" Spruce | Pipe | |
| S59°W 57.89' 12" J. Pine | S40°E 61.45' 12" Spruce | |
| | S59°W 57.89' 12" J. Pine - ½" Rod & Cap | |

B. Description of corner evidence found and/or method applied in restoring or reestablishing corner:

- Found ½" Rod, set Cap #22428
- S40°E 61.51' 24" Spruce

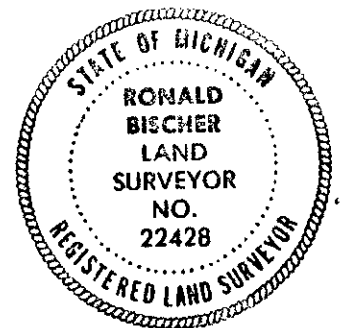

C. Description of monument for corner and accessories established to perpetuate locating the position of the corner:

- ½" Rod and Cap #22428
- S40°E 61.51' 24" Spruce
- S39°W 96.10' 14" Spruce
- S60°W 89.79' 14" Spruce
- N75°W 82.27' 7" Maple
- Nails with witness tag #22428 used.

Ratified by Peer Group
in accordance with P.A. 345
Chairman *Delmar E. Porter*
Date 9/20/95

Signed by Ronald E. Bischer
Surveyor's Michigan License No. 22428

Date Oct 3, 1995