

RECORDED

LAND CORNER RECORDATION CERTIFICATE
 Filing Requirement of Act 74, Mich. P.A. 1970

94 SEP 12 AM 10:41

Jane M. Lamb
 REGISTER OF DEEDS

LIBER 311 PAGE 242

Register of Deeds Stamp & File Number

For corners in

Presque Isle (County)	Located In:	Corner Code #
1. Public Land Survey	T <u>36N</u> R <u>2E</u>	<u>K-8</u>
	T _____ R _____	_____
	T _____ R _____	_____
	T _____ R _____	_____
2. Property Controlling in Section	S _____ T _____ R _____	_____
	S _____ T _____ R _____	_____
3. Miscellaneous Property in Sec.	S _____ T _____ R _____	_____
	S _____ T _____ R _____	_____

4. Lot No. _____, Recorded Plat _____
 5. Private Claims _____

	A	B	C	D	E	F	G	H	I	J	K	L	M
2	6	5	4	3	2	1							
3													
4	7	8	9	10	11	12							
5													
6	18	17	16	15	14	13							
7													
8	19	20	21	22	23	24							
9													
10	30	29	28	27	26	25							
11													
12	31	32	33	34	35	36							
13													

I, James A. Beck, in a field survey on March 7, 1994, do hereby certify that under requirements of P.A. 74, Michigan P.A. of 1970, the corner points mentioned in lines 1 and 2 above were in conformance with regulations and rules therefore as required in the current manual of survey instructions of the United States Department of the Interior, Bureau of Land Management or by a decree of a Court of Law and/or that the corner points mentioned in lines 3, 4 and 5 above were in conformance with the rules of the Michigan Board of Land Surveyors or by a Decree of a Court of Law; established, re-established, monumented, re-monumented, recovered, found as expressed below:

NOTE: Not more than 4 corners, all in the same town and range, may be recorded on this certificate.


A. Description of original monument and accessories and/or subsequent restoration:

K-8
 1856: Original monumentation in Government Resurvey.
 Set post corner of Sections 23 and 24 and referenced:
 W Pine 24" N60°E 34 Links
 Cedar 10" S54°W 19 Links

B. Description of corner evidence found and/or method applied in restoring or reestablishing corner:

K-8
 1994: Found 1/2" bent iron rod and three witnesses as documented in survey by Delmer E. Porter, P.S. 15410 (Survey recorded March 9, 1984, L. 252, P. 256, Presque Isle County Records);
 Witnesses found (as recorded):
 N50°E 35.70' 6" Maple
 N60°E 22.40' OBT Stump
 S68°W 48.89' 10" Maple

Ratified by Peer Group
 in accordance with P.A. 345,
 Chairman *Delmer E. Porter*
 Date August 29, 1994

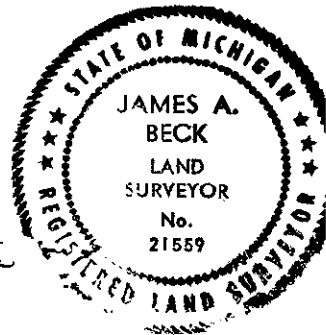

C. Description of monument for corner and accessories established to perpetuate locating the position of the corner:

K-8
 1994: 1/2" iron rod and cap P.S. 21559 in centerline of North-South gravel roadway.
 Witnesses:
 N50°E 35.70' 7" Twin Maple (P.R., tag 21559)
 N60°E 22.40' Pine OBT Stump (P.R.)
 S68°W (r) 48.89' (m) 48.81' 13" Maple (P.R., tag 22428, Ronald R. Bischer)
 N33°W 46.00' 7" Maple (tag 21559)
 S81°E 43.97' 10" Spruce (tag 21559)

P. R. = Previously Recorded

Signed by *James A. Beck* Date August 25, 1994
 Surveyor's Michigan License No. 21559

2459