

LAND CORNER RECORDATION CERTIFICATE
 Filing Requirement of Act 74, Mich. P.A. 1970

94 SEP 12 AM 10:41

For corners in

<u>Presque Isle</u> (County)	Located In:	Corner Code #
1. Public Land Survey	T <u>36N</u> R <u>2E</u>	<u>K-9</u>
	T _____ R _____	_____
	T _____ R _____	_____
	T _____ R _____	_____
2. Property Controlling in Section	S _____ T _____ R _____	_____
	S _____ T _____ R _____	_____
3. Miscellaneous Property in Sec.	S _____ T _____ R _____	_____
	S _____ T _____ R _____	_____
4. Lot No. _____, Recorded Plat _____		
5. Private Claims _____		

Janet M. Lamb
 REGISTER OF DEEDS

LIBER **311** PAGE **241**

Register of Deeds Stamp & File Number

I, James A. Beck, in a field survey on March 15, 19 94, do hereby certify that under requirements of P.A. 74, Michigan P.A. of 1970, the corner points mentioned in lines 1 and 2 above were in conformance with regulations and rules therefore as required in the current manual of survey instructions of the United States Department of the Interior, Bureau of Land Management or by a decree of a Court of Law and/or that the corner points mentioned in lines 3, 4 and 5 above were in conformance with the rules of the Michigan Board of Land Surveyors or by a Decree of a Court of Law; established, re-established, monumented, re-monumented, recovered, found as expressed below:

NOTE: Not more than 4 corners, all in the same town and range, may be recorded on this certificate.

A	B	C	D	E	F	G	H	I	J	K	L	M
2	6	5	4	3	2	1						
3												
4	7	8	9	10	11	12						
5												
6	18	17	16	15	14	13						
7												
8	19	20	21	22	23	24						
9												
10	30	29	28	27	26	25						
11												
12	31	32	33	34	35	36						
13												

A. Description of original monument and accessories and/or subsequent restoration:


K-9
 1856: Original monumentation in Government Resurvey. Set post at corner of Sections 23, 24, 25 and 26 and referenced:
 W Pine 9" N25°W 13 Links
 Aspen 9" S54°E 15 Links

B. Description of corner evidence found and/or method applied in restoring or reestablishing corner:

K-9
 1994: Found 5/8" Iron rod in road intersection and three witnesses as recorded in survey by Delmer E. Porter, P.S. 15410 (Survey recorded March 9, 1984, L. 252, P. 256, Presque Isle County Records).
 Witnesses found (as recorded):
 N56°E 67.44' SW Corner Cement Block House
 S30°E 32.78' 6" Maple
 S51°W 43.76' 10" Maple

Ratified by Peer Group
 in accordance with P.A. 345

Chairman Delmer E. Porter
 Date August 29, 1994

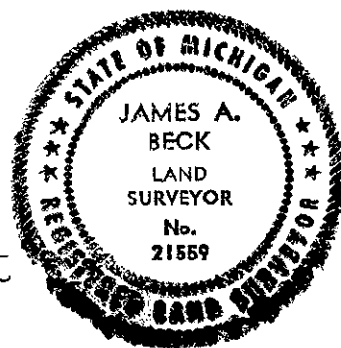

C. Description of monument for corner and accessories established to perpetuate locating the position of the corner:

K-9
 1994: 5/8" iron rod and cap P.S. 21559 in center of North-South gravel road at Northerly side of gravel road to the West.
 Witnesses:
 N56°E (r) 67.44' (m) 67.41' SW Corner Cement Block House (P.R.)
 S30°E (r) 32.78' (m) 32.81' 7" Maple (P.R., tag 22428-Ronald R. Bischer)
 S51°W (r) 43.76' (m) 43.74' 11" Maple (P.R., tag 22428-Ronald R. Bischer)
 N55°W 51.78' 10" Maple (set tag P.S. 21559)
 N42°E 85.71' NW Corner Cement Block House

P. R. = Previously Recorded

Signed by James A. Beck Date August 25, 1994
 Surveyor's Michigan License No. 21559

2459