

PRESQUE ISLE COUNTY  
 RECORDED

**LAND CORNER RECORDATION CERTIFICATE**  
 Filing Requirement of Act 74, Mich. P.A. 1970

94 SEP 12 AM 10:41

For corners in

<u>Presque Isle</u> (County)	Located In:	Corner Code #
1. Public Land Survey	T <u>36N</u> R <u>2E</u>	<u>K-10</u>
	T _____ R _____	_____
	T _____ R _____	_____
	T _____ R _____	_____
2. Property Controlling in Section	S _____ T _____ R _____	_____
	S _____ T _____ R _____	_____
3. Miscellaneous Property in Sec.	S _____ T _____ R _____	_____
	S _____ T _____ R _____	_____
4. Lot No. _____, Recorded Plat _____		
5. Private Claims _____		

*Janet M. Lamb*  
 REGISTER OF DEEDS

LIBER **311** PAGE **240**

Register of Deeds Stamp & File Number

I, James A. Beck, in a field survey on March 15, 19 94, do hereby certify that under requirements of P.A. 74, Michigan P.A. of 1970, the corner points mentioned in lines 1 and 2 above were in conformance with regulations and rules therefore as required in the current manual of survey instructions of the United States Department of the Interior, Bureau of Land Management or by a decree of a Court of Law and/or that the corner points mentioned in lines 3, 4 and 5 above were in conformance with the rules of the Michigan Board of Land Surveyors or by a Decree of a Court of Law; established, re-established, monumented, re-monumented, recovered, found as expressed below:

	A	B	C	D	E	F	G	H	I	J	K	L	M
2	6	5	4	3	2								
3													
4	7	8	9	10	11	12							
5													
6	18	17	16	15	14	13							
7													
8	19	20	21	22	23	24							
9													
10	30	29	28	27	26	25							
11													
12	31	32	33	34	35	36							
13													

**NOTE: Not more than 4 corners, all in the same town and range, may be recorded on this certificate.**

A. Description of original monument and accessories and/or subsequent restoration:

- K-10  
 1856: Original monumentation in Government Resurvey. Set post at quarter corner and referenced:  
 W Birch 9" N65°E 23 Links  
 Hemlock 16" S40°W 29 Links
- 1979: Ronald R. Bischer, P.S. 22428, set 1/2" rod by single proportion (corner recorded Nov. 8, 1979, Presque Isle County Records). Referenced:  
 N43°E 45.59' 9" Birch  
 S21°E 36.16' 10" Maple  
 S74°W 61.18' 6" Maple

B. Description of corner evidence found and/or method applied in restoring or reestablishing corner:

- K-10  
 1994: Found 1/2" iron rod and three witnesses as recorded by Ronald R. Bischer, P.S. 22428 (see above).


Ratified by Peer Group  
 in accordance with P.A. 345

Chairman Delmer E. Pater

Date August 29, 1994

C. Description of monument for corner and accessories established to perpetuate locating the position of the corner:

- K-10  
 1994: 1/2" iron rod and cap P.S. 21559 in Easterly side of gravel road at Northerly side of dirt road running Easterly.  
 Witnesses:  
 N43°E 45.59' 10" Birch Stump (P.R.)\*  
 S21°E 36.16' 10" Maple Stump (P.R.)\*  
 S74°W 61.18' 8" Maple (P.R.)\*  
 N45°E 43.25' 6" Maple\*  
 S73°E 79.76' 3" Birch in clump\*  
 N75°W 82.27' 16" Beech\*  
 \* = set tag P.S. 21559  
 P.R. = Previously Recorded

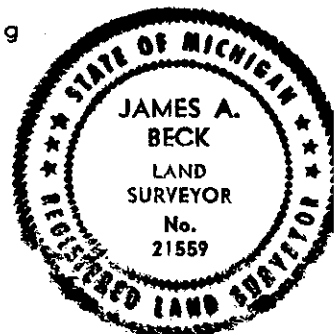

Signed by James A. Beck  
 Surveyor's Michigan License No. 21559

Date August 25, 1994

2459