

State of Michigan Remonumentation Program
For Presque Isle County.

PRESQUE ISLE COUNTY
RECORDED

LAND CORNER RECORDATION CERTIFICATE
Filing Requirement of Act 74, Mich. P.A. 1970

94 AUG 23 AM 10:13

For corners in

<u>PRESQUE ISLE</u> (County)	Located In:	Corner Code #
1. Public Land Survey	T <u>36N</u> R <u>2E</u>	<u>K-12</u>
	T _____ R _____	_____
	T _____ R _____	_____
	T _____ R _____	_____
2. Property Controlling in Section	S _____ T _____ R _____	_____
	S _____ T _____ R _____	_____
3. Miscellaneous Property in Sec.	S _____ T _____ R _____	_____
	S _____ T _____ R _____	_____

Janet M. Lamb
REGISTER OF DEEDS

LIBER **310** PAGE **945**

Register of Deeds Stamp & File Number

4. Lot No. _____, Recorded Plat _____
5. Private Claims _____

	A	B	C	D	E	F	G	H	I	J	K	L	M
2	6	5	4	3	2	1							
3													
4	7	8	9	10	11	12							
5													
6	13	17	16	15	14	13							
7													
8	19	20	21	22	23	24							
9													
10	30	29	28	27	26	25							
11													
12	31	32	33	34	35	36							
13													

I, Ronald Bischer, in a field survey on May 5, 19 94, do hereby certify that under requirements of P.A. 74, Michigan P.A. of 1970, the corner points mentioned in lines 1 and 2 above were in conformance with regulations and rules therefore as required in the current manual of survey instructions of the United States Department of the Interior, Bureau of Land Management or by a decree of a Court of Law and/or that the corner points mentioned in lines 3, 4 and 5 above were in conformance with the rules of the Michigan Board of Land Surveyors or by a Decree of a Court of Law; established, re-established, monumented, re-monumented, recovered, found as expressed below:


NOTE: Not more than 4 corners, all in the same town and range, may be recorded on this certificate.

A. Description of original monument and accessories and/or subsequent restoration:

1856 Resurvey - GLO Notes	10-30-79 - Ronald R. Bischer
Set Wood Post	1/2" Rod
W. Birch N60°W 14 links	N46°W 22.15' 6" Oak
Aspen 10" S55°E 8 links	S25°E 51.92' 8" Norway
	S32°W 38.51' 6" Birch
10-19-79 - Ronald R. Bischer	
Set 1/2" Rod by Single proportion	
S32°W 38.51' 6" Birch	
S25°E 51.92' 8" Norway	
N46°W 22.15' 6" Oak	

B. Description of corner evidence found and/or method applied in restoring or reestablishing corner:

Found 1/2" Rod and Cap #15410
N46°W 22.15' 8" Oak
S25°E 51.92' 8" Norway
stump remains intact
S32°W 38.51' 8" Birch

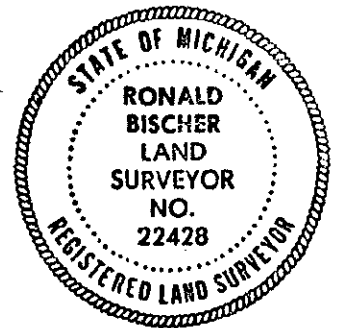

SURVEY &
REMONUMENTATION

SEP 09 1994

COMMISSION

C. Description of monument for corner and accessories established to perpetuate locating the position of the corner:

1/2" Rod and Cap #15410
N46°W 22.15' 8" Oak
S32°W 38.51' 8" Birch
S23°E 45.69' 8" Birch
S70°W 12.68' 3" Maple

Ratified by Peer Group
in accordance with P.A. 345

Chairman *Delmer E. Porter*

Date July 29, 1994

Witness tags and nails used.

Signed by Ronald R. Bischer

Date July 20, 1994

Surveyor's Michigan License No. 22428