

LAND CORNER RECCRDATION CERTIFICATE
Filing Requirement of Act 74, Mich. P.A. 1970

94 SEP 12 AM 10:40

For corners in

<u>Presque Isle</u> (County)	Located In:	Corner Code #
1. Public Land Survey	T <u>36N</u> R <u>2E</u>	<u>L-9</u>
	T _____ R _____	_____
	T _____ R _____	_____
	T _____ R _____	_____
2. Property Controlling in Section	S _____ T _____ R _____	_____
	S _____ T _____ R _____	_____
3. Miscellaneous Property in Sec.	S _____ T _____ R _____	_____
	S _____ T _____ R _____	_____
4. Lot No. _____, Recorded Plat _____		
5. Private Claims _____		

Janet M. Lamb
REGISTER OF DEEDS

LIBER 311 PAGE 238

Register of Deeds Stamp & File Number

I, James A. Beck, in a field survey on July 5, 1994, do hereby certify that under requirements of P.A. 74, Michigan P.A. of 1970, the corner points mentioned in lines 1 and 2 above were in conformance with regulations and rules therefore as required in the current manual of survey instructions of the United States Department of the Interior, Bureau of Land Management or by a decree of a Court of Law and/or that the corner points mentioned in lines 3, 4 and 5 above were in conformance with the rules of the Michigan Board of Land Surveyors or by a Decree of a Court of Law; established, re-established, monumented, re-monumented, recovered, found as expressed below:

A	B	C	D	E	F	G	H	I	J	K	L	M
2	6	5	4	3	2	1						
3												
4	7	8	9	10	11	12						
5												
6	18	17	16	15	14	13						
7												
8	19	20	21	22	23	24						
9												
10	30	29	28	27	26	25						
11												
12	31	32	33	34	35	36						
13												

NOTE: Not more than 4 corners, all in the same town and range, may be recorded on this certificate.

A. Description of original monument and accessories and/or subsequent restoration:

- L-9
1856: Original monumentation in Government Resurvey. Set post at quarter corner and referenced:
W Pine 8" N80°W 24 Links
W Pine 12" S85°W 64 Links
- 1976: Delmer E. Porter, P.S. 15410, set 1/2" rod and cap P.S. 15410 by single proportion. (Corner Card furnished by Porter's Survey). Referenced:
N84°W 44.15' 20" Spruce
North 16' Old Trail
S37°W 12.47' 9" Maple

B. Description of corner evidence found and/or method applied in restoring or reestablishing corner:

- L-9
1994: Found 1/2" iron rod and cap R.L.S. 15410 (Delmer E. Porter) and two witnesses as recorded by Delmer E. Porter (see above).
Witnesses found (as recorded):
N84°W 44.15' 20" Spruce
S37°W 12.47' 9" Maple


C. Description of monument for corner and accessories established to perpetuate locating the position of the corner:

- L-9
1994: 1/2" iron rod and cap P.S. 21559 in Northeasterly corner of recently cut area, approximately 16' South of 2-track roadway.
Witnesses:
N84°W 44.15' 18" Spruce* (P.R.)
S37°W (r) 12.47' (m) 12.50' 12" Maple* (P.R.)
N03°E 37.88' 9" Oak*
N37°W 50.09' 7" Maple*
North 33.0' 1/2" iron with cap R.L.S. 15410
* = Set tag P.S. 21559
P.R. = Previously Recorded

Ratified by Peer Group
in accordance with P.A. 345

Chairman *Delmer E. Porter*

Date August 29, 1994

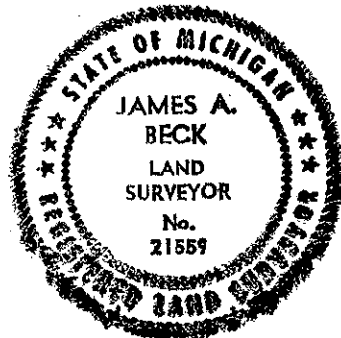

Signed by *James A. Beck*
Surveyor's Michigan License No. 21559

Date August 25, 1994

2459