

PRESQUE ISLE COUNTY  
 REMONUMENTATION  
 RECORDED

**LAND CORNER RECORDATION CERTIFICATE**  
 Filing Requirement of Act 74, Mich. P.A. 1970

94 SEP 12 AM 10:40

For corners in

Presque Isle (County)	Located In:	Corner Code #
1. Public Land Survey	T 36N R 2E	L-11
	T ___ R ___	_____
	T ___ R ___	_____
	T ___ R ___	_____
2. Property Controlling in Section	S ___ T ___ R ___	_____
	S ___ T ___ R ___	_____
3. Miscellaneous Property in Sec.	S ___ T ___ R ___	_____
	S ___ T ___ R ___	_____
4. Lot No. _____, Recorded Plat _____		
5. Private Claims _____		

*Janet M. Lamb*  
 REGISTER OF DEEDS

LIBER 311 PAGE 236

Register of Deeds Stamp & File Number

I, James A. Beck, in a field survey on July 29, 1994, do hereby certify that under requirements of P.A. 74, Michigan P.A. of 1970, the corner points mentioned in lines 1 and 2 above were in conformance with regulations and rules therefore as required in the current manual of survey instructions of the United States Department of the Interior, Bureau of Land Management or by a decree of a Court of Law and/or that the corner points mentioned in lines 3, 4 and 5 above were in conformance with the rules of the Michigan Board of Land Surveyors or by a Decree of a Court of Law; established, re-established, monumented, re-monumented, recovered, found as expressed below:

**NOTE: Not more than 4 corners, all in the same town and range, may be recorded on this certificate.**

	A	B	C	D	E	F	G	H	I	J	K	L	M
2	6	5	4	3	2	1							
3													
4	7	8	9	10	11	12							
5													
6	18	17	16	15	14	13							
7													
8	19	20	21	22	23	24							
9													
10	30	29	28	27	26	25							
11													
12	31	32	33	34	35	36							


**A. Description of original monument and accessories and/or subsequent restoration:**

- L-11  
 1856: Original monumentation in Government Resurvey. Set post at 1/4 corner and referenced:  
 Cedar 9" N32°E 11 Links  
 Sp Pine 9" S70°W 16 Links
- 1979: Ronald R. Bischer, P.S. 22428, set 1/2" rod by single proportion. (Corner recorded Nov. 8, 1979, Presque Isle County Records) Referenced:  
 N02°E 31.07' 14" Spruce  
 N82°E 63.28' 12" Spruce  
 S05°W 37.83' 8" Maple

**B. Description of corner evidence found and/or method applied in restoring or reestablishing corner:**

- L-11  
 1994: Found 1/2" iron rod and two witnesses as recorded by Ronald R. Bischer, P.S. 22428 (see above). Witnesses found (as recorded):  
 N82°E 63.28' 12" Spruce  
 S05°W 37.83' 8" Maple

Ratified by Peer Group  
 in accordance with P.A. 345  
 Chairman *Delmer E. Porter*  
 Date August 29, 1994

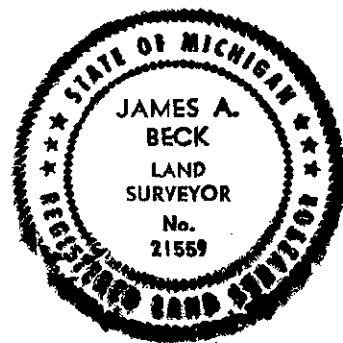

**C. Description of monument for corner and accessories established to perpetuate locating the position of the corner:**

- L-11  
 1994: 1/2" iron rod and cap P.S. 21559 at mean centerline of road to West extended and in curve of road running Southeasterly.  
 Witnesses:  
 N82°E (r) 63.28' (m) 63.53' 14" Spruce (P.R., tag 15410-Delmer E. Porter)  
 S05°W 37.83' 11" Maple (P.R.)\*  
 N26°W 25.32' 8" Maple\*  
 S45°W 37.70' 10" White Birch\*  
 S60°W 24.33' 7" Maple\*
- P. R. = Previously Recorded  
 \* = Set Toq P.S. 21559

Signed by *James A. Beck*  
 Surveyor's Michigan License No. 21559

Date August 25, 1994