

State of Michigan Remonumentation Program  
For Presque Isle County

PRESQUE ISLE COUNTY  
RECORDED

LAND CORNER RECORDATION CERTIFICATE  
Filing Requirement of Act 74, Mich. P.A. 1970

94 AUG 23 AM 10:11

For corners in

PRESQUE ISLE  
(County)

Located In:

Corner Code ##

*June M. Lamb*  
REGISTER OF DEEDS

- |                                    |   |              |           |             |
|------------------------------------|---|--------------|-----------|-------------|
| 1. Public Land Survey              | T | <u>36N</u> R | <u>2E</u> | <u>L-13</u> |
|                                    | T | _____ R      | _____     | _____       |
|                                    | T | _____ R      | _____     | _____       |
|                                    | T | _____ R      | _____     | _____       |
| 2. Property Controlling in Section | S | _____ T      | _____ R   | _____       |
|                                    | S | _____ T      | _____ R   | _____       |
| 3. Miscellaneous Property in Sec.  | S | _____ T      | _____ R   | _____       |
|                                    | S | _____ T      | _____ R   | _____       |

LIBER **310** PAGE **938**

Register of Deeds Stamp & File Number

4. Lot No. \_\_\_\_\_, Recorded Plat \_\_\_\_\_  
5. Private Claims \_\_\_\_\_

I, Ronald Bischer, in a field survey on April 7, 19 94, do hereby certify that under requirements of P.A. 74, Michigan P.A. of 1970, the corner points mentioned in lines 1 and 2 above were in conformance with regulations and rules therefore as required in the current manual of survey instructions of the United States Department of the Interior, Bureau of Land Management or by a decree of a Court of Law and/or that the corner points mentioned in lines 3, 4 and 5 above were in conformance with the rules of the Michigan Board of Land Surveyors or by a Decree of a Court of Law; established, re-established, monumented, re-monumented, recovered, found as expressed below:

**NOTE: Not more than 4 corners, all in the same town and range, may be recorded on this certificate.**

	A	B	C	D	E	F	G	H	I	J	K	L	M
2	6	5	4	3	2	1							
3													
4	7	8	9	10	11	12							
5													
6	18	17	16	15	14	13							
7													
8	19	20	21	22	23	24							
9													
10	30	29	28	27	26	25							
11													
12	31	32	33	34	35	36							
13													

A. Description of original monument and accessories and/or subsequent restoration:

- |                                 |                              |              |                               |
|---------------------------------|------------------------------|--------------|-------------------------------|
| L-13                            | N42°E 50.78'                 | 20" Spruce   | 1979 - Ronald Bischer         |
| GLO Notes, Resurvey 1856        | S32°E 25.21'                 | 5" Maple     | 1/2" Rod in 2 1/2" Pipe       |
| Set Wood Post                   | S39°W 86.41'                 | 8" Cedar     | N42°E 50.78' 20" Spruce       |
| Pine 6" N55°E 9 links           | 1979 - Delmar E. Porter      |              | S32°E 25.21' 5" Maple         |
| Birch 4" N70°W 25 links         | Found 2" Pipe, Replaced pipe |              | S39°W 86.41' 8" Cedar         |
| 1935 - Marcus Schaaf            | with conc. mon. w/brass cap  |              | 1979 - Delmar E. Porter       |
| Set 2 1/2" Pipe                 | N42°E 50.86'                 | 14" Balsam   | Concrete Monument w/brass cap |
| 1979 - Delmar E. Porter         | S33°E 25.15'                 | Tw. 8" Maple | N42°E 50.86' 14" Balsam       |
| Found 2 1/2" Pipe, set 1/2" Rod | S38°W 86.40'                 | 8" Cedar     | S33°E 25.15' Tw. 8" Maple     |
| in center of pipe               |                              |              | S38°W 86.40' 8" Cedar         |


B. Description of corner evidence found and/or method applied in restoring or reestablishing corner.

- L-13  
Found Concrete Monument with brass cap lettered "Presque Isle County Remonumentation"  
N42°E 50.78' 20" Spruce  
witness dead and blown over  
S32°E 25.21' 6" Maple  
S39°W 86.41' 10" Cedar

SURVEY &  
REMONUMENTATION

SEP 09 1994

COMMISSION

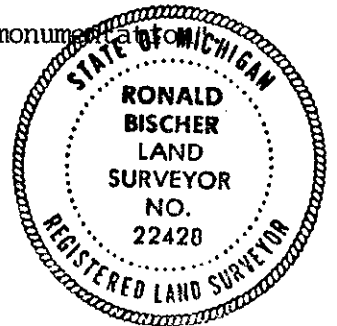

C. Description of monument for corner and accessories established to perpetuate locating the position of the corner:

- L-13  
Presque Isle County Remonumentation Monument  
S32°E 25.21' 6" Maple  
S39°W 86.41' 10" Cedar  
N47°E 31.05' 6" Maple  
N23°W 20.13' 3" Balsam fir

Ratified by Peer Group  
in accordance with P.A. 345

Chairman *Delmar E. Porter*

Date July 27, 1994

\*Witness tags w/nails used.

Signed by Ronald R. Bischer

Date July 20, 1994

Surveyor's Michigan License No. 22428