

1995 PRESQUE ISLE COUNTY, STATE OF MICHIGAN REMONUMENTATION

JAN 17 1996

2237

COMMISSION

LAND CORNER RECORDATION CERTIFICATE

Filing Requirement of Act 74, Mich. P.A. 1970

For corners in

PRESQUE ISLE  
(County)

Located In:

Corner Code #

PRESQUE ISLE COUNTY  
RECORDED

95 OCT 20 PM 4:35

*Jane M. Slamb*  
REGISTER OF DEEDS

LIBER 316 PAGE 320

Register of Deeds Stamp & File Number

- |                                    |   |            |   |           |            |
|------------------------------------|---|------------|---|-----------|------------|
| 1. Public Land Survey              | T | <u>36N</u> | R | <u>2E</u> | <u>M-2</u> |
|                                    | T | ___        | R | ___       | ___        |
|                                    | T | ___        | R | ___       | ___        |
|                                    | T | ___        | R | ___       | ___        |
| 2. Property Controlling in Section | S | ___        | T | ___       | ___        |
|                                    | S | ___        | T | ___       | ___        |
| 3. Miscellaneous                   | S | ___        | T | ___       | ___        |
| Property in Section                | S | ___        | T | ___       | ___        |

4. Lot No. \_\_\_\_\_, Recorded Plat \_\_\_\_\_

5. Private Claims \_\_\_\_\_

|    | A  | B | C  | D | E  | F | G  | H | I  | J | K  | L | I |
|----|----|---|----|---|----|---|----|---|----|---|----|---|---|
| 2  | 6  |   | 5  |   | 4  |   | 3  |   | 2  |   |    |   |   |
| 3  |    |   |    |   |    |   |    |   |    |   |    |   |   |
| 4  | 7  |   | 8  |   | 9  |   | 10 |   | 11 |   | 12 |   |   |
| 5  |    |   |    |   |    |   |    |   |    |   |    |   |   |
| 6  | 18 |   | 17 |   | 16 |   | 15 |   | 14 |   | 13 |   |   |
| 7  |    |   |    |   |    |   |    |   |    |   |    |   |   |
| 8  | 19 |   | 20 |   | 21 |   | 22 |   | 23 |   | 24 |   |   |
| 9  |    |   |    |   |    |   |    |   |    |   |    |   |   |
| 10 | 30 |   | 29 |   | 28 |   | 27 |   | 26 |   | 25 |   |   |
| 11 |    |   |    |   |    |   |    |   |    |   |    |   |   |
| 12 | 31 |   | 32 |   | 33 |   | 34 |   | 35 |   | 36 |   |   |
| 13 |    |   |    |   |    |   |    |   |    |   |    |   |   |

I, Ronald Bischer, in a field survey on August 9, 19 95, do hereby certify that under requirements of P.A. 74, Michigan P.A. of 1970, the corner points mentioned in lines 1 and 2 above were in conformance with regulations and rules therefore as required in the current manual of survey instructions of the United States Department of the Interior, Bureau of Land Management or by a decree of a Court of Law and/or that the corner points mentioned in lines 3, 4 and 5 above were in conformance with the rules of the Michigan Board of Professional Surveyors or by a Decree of a Court of Law; established, re-established, monumented, re-monumented, recovered, found as expressed below:

**NOTE: Not more than 4 corners, all in the same town and range, may be recorded on this certificate.**

A. Description of original monument and accessories and/or subsequent restoration:

GLO Notes - 1856 Resurvey  
Geo H. Cannon  
Set wood post


W. Pine 11" N47 $\frac{1}{2}$  $^{\circ}$ W 62 lks  
W. Pine 18" S48 $^{\circ}$ W 50 lks

12-01-75 - Delmar E. Porter  
#15410  $\frac{1}{2}$ " Rod & Cap  
N81 $^{\circ}$ W 38.53' 18" Pine  
N10 $^{\circ}$ E 33.85' Cor. of bldg.

S21 $^{\circ}$ W 74.99' 8" Pine  
01-17-76 - Delmar E. Porter  
Set  $\frac{1}{2}$ " Rod & Cap from existing corners of Golden Beach Plat. Witnesses same as 12-01-75.  
07-28-76, 04-29-77, 06-28-77  
Delmar E. Porter  
Corner and witnesses same as on 12-01-75.

B. Description of corner evidence found and/or method applied in restoring or reestablishing corner:

Found  $\frac{1}{2}$ " Rod and Cap #15410  
S17 $^{\circ}$ W 74.99' 12" N. Pine  
N81 $^{\circ}$ W 38.53' 18" Pine - dead  
N10 $^{\circ}$ E Building is gone.

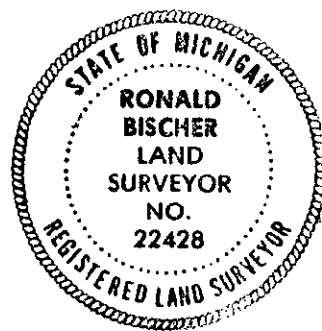

C. Description of monument for corner and accessories established to perpetuate locating the position of the corner:

$\frac{1}{2}$ " Rod and Cap #15410  
S17 $^{\circ}$ W 74.99' 12" Norway Pine  
S80 $^{\circ}$ W 33.58' 3" Oak  
S29 $^{\circ}$ W 75.19' 16" White Pine  
S12 $^{\circ}$ E 87.80' Power pole

Nails with witness tag #22428 used.

Ratified by Peer Group  
in accordance with P.A. 345  
Chairman *Delmar E. Porter*  
Date 9/20/95

Signed by *Ronald R. Bischer*

Date Oct. 3, 1995

Surveyor's Michigan License No. 22428