

SURVEY & MONUMENTATION
 1995 PRESQUE ISLE COUNTY, STATE OF MICHIGAN REMONUMENTATION

2238

JAN 17 1996

COMMISSION LAND CORNER RECORDATION CERTIFICATE
 Filing Requirement of Act 74, Mich. P.A. 1970

LIBER **316** PAGE **321**

For corners in
PRESQUE ISLE
(County)

Located In:

Corner Code #

PRESQUE ISLE COUNTY
 RECORDED

95 OCT 20 PM 4:35

Jane M. Lamb
 REGISTER OF DEEDS

Register of Deeds Stamp & File Number

- | | | | | | | |
|--------------------------------------|---|------------|---|-----------|------------|-------|
| 1. Public Land Survey | T | <u>36N</u> | R | <u>2E</u> | <u>M-3</u> | |
| | T | _____ | R | _____ | _____ | |
| | T | _____ | R | _____ | _____ | |
| | T | _____ | R | _____ | _____ | |
| 2. Property Controlling in Section | S | _____ | T | _____ | R | _____ |
| | S | _____ | T | _____ | R | _____ |
| 3. Miscellaneous Property in Section | S | _____ | T | _____ | R | _____ |
| | S | _____ | T | _____ | R | _____ |

4. Lot No. _____, Recorded Plat _____
 5. Private Claims _____

A	B	C	D	E	F	G	H	I	J	K	L	M
2	6		5		4		3		2			
3												
4	7		8		9		10		11		12	
5												
6	18		17		16		15		14		13	
7												
8	19		20		21		22		23		24	
9												
10	30		29		28		27		26		25	
11												
12	31		32		33		34		35		36	
13												

I, Ronald Bischer, in a field survey on August 8, 19 95, do hereby certify that under requirements of P.A. 74, Michigan P.A. of 1970, the corner points mentioned in lines 1 and 2 above were in conformance with regulations and rules therefore as required in the current manual of survey instructions of the United States Department of the Interior, Bureau of Land Management or by a decree of a Court of Law and/or that the corner points mentioned in lines 3, 4 and 5 above were in conformance with the rules of the Michigan Board of Professional Surveyors or by a Decree of a Court of Law; established, re-established, monumented, re-monumented, recovered, found as expressed below:


NOTE: Not more than 4 corners, all in the same town and range, may be recorded on this certificate.

A. Description of original monument and accessories and/or subsequent restoration:

GLO Notes - 1856 Resurvey Geo. H. Cannon Set wood post	08-01-72 - James L. Scott, #8818 Shows cor. being 9.45' W. of centerline.
Y. Pine 12" N21°W 13 lks	12-01-75, 07-28-76, 07-28-77
W. Pine 14" S28°W 30 lks	Delmar E. Porter, #15410
Y. Pine 14" N16°E 37 lks	P.K. Nail in road
W. Pine 10" S70°E 30 lks	S55°W 65.00' Power pole
	N60°W 90.45' 15" N. Pine
1971 - MSHD US-23 Highway plans Shows cor. 9.45' W. of Cntrline	

B. Description of corner evidence found and/or method applied in restoring or reestablishing corner:

Found P.K. Nail, replaced with 1/2" Rod and Cap #22428
 N64°W 90.45' 20" Norway Pine
 East 9.45' Centerline of US-23

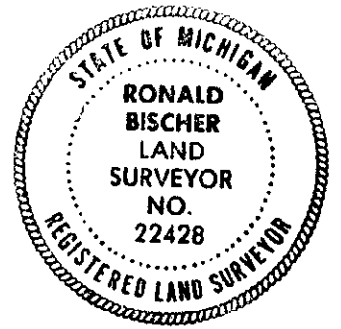

C. Description of monument for corner and accessories established to perpetuate locating the position of the corner:

1/2" Rod and Cap #22428, 9.45' East of Centerline of US-23
 N64°W 90.45' 20" Norway Pine
 N58°W 83.60' 14" Norway Pine
 N50°E 75.80' 5" Norway Pine
 S64°W 64.65' Telephone cable box

Ratified by Peer Group
 in accordance with P.A. 345

Chairman *Delmar E. Porter*
 Date 9/28/95

Nails with witness tag #22428 used.

Signed by Ronald R. Bischer

Date Oct. 3, 1995

Surveyor's Michigan License No. 22428