

RECORDATION
 PRESQUE ISLE COUNTY
 RECORDED
 94 SEP 12 AM 10:40

LAND CORNER RECORDATION CERTIFICATE
 Filing Requirement of Act 74, Mich. P.A. 1970

For corners in
Presque Isle
 (County)

Located In: Corner Code #

1. Public Land Survey	T <u>36N</u> R <u>2E</u>	<u>M-9</u>
	T _____ R _____	_____
	T _____ R _____	_____
	T _____ R _____	_____
2. Property Controlling in Section	S _____ T _____ R _____	_____
	S _____ T _____ R _____	_____
3. Miscellaneous Property in Sec.	S _____ T _____ R _____	_____
	S _____ T _____ R _____	_____

Janet M. Lamb
 REGISTER OF DEEDS

LIBER **311** PAGE **235**

Register of Deeds Stamp & File Number

4. Lot No. _____, Recorded Plat _____
 5. Private Claims _____

A	B	C	D	E	F	G	H	I	J	K	L	M
2	6	5	4	3	2	1						
3												
4	7	8	9	10	11	12						
5												
6	18	17	16	15	14	13						
7												
8	19	20	21	22	23	24						
9												
10	30	29	28	27	26	25						
11												
12	31	32	33	34	35	36						
13												

I, James A. Beck, in a field survey on July 19, 19 94, do hereby certify that under requirements of P.A. 74, Michigan P.A. of 1970, the corner points mentioned in lines 1 and 2 above were in conformance with regulations and rules therefore as required in the current manual of survey instructions of the United States Department of the Interior, Bureau of Land Management or by a decree of a Court of Law and/or that the corner points mentioned in lines 3, 4 and 5 above were in conformance with the rules of the Michigan Board of Land Surveyors or by a Decree of a Court of Law; established, re-established, monumented, re-monumented, recovered, found as expressed below:

NOTE: Not more than 4 corners, all in the same town and range, may be recorded on this certificate.

A. Description of original monument and accessories and/or subsequent restoration:

M-9
 1856: Original monumentation in Government Resurvey.
 Set post at corner of Sections 24 and 25 and referenced:
 Aspen 11" N34°W 20 Links Aspen 11" S35°W 19 Links


(circa 1972): 1" x 4 1/2' pipe
 Notes from survey 25.44' 5" Twin Birch N 00°00' E
 by Doyle Engineering 53.26' 14" Balsam N 40°30' E
 (furnished by James Granger, 23.15' 13" twin Balsam S 62°00' W
 Granger & Associates). 30.39' 6" Birch N 55°00' W

October, 1975: Found 1" pipe.
 Survey by Delmer E. Porter, Due N 25.43' 5" Birch - old witness; S40°E 32' OBT - cedar stump w blaze facing pipe
 P.S. 15410. S61°W 23.20' Tw 10" Balsam - old witness; N56°W 30.36' 7" Birch - old witness

B. Description of corner evidence found and/or method applied in restoring or reestablishing corner:

M-9
 1994: Found 1" pipe and four witnesses as recorded by Delmer E. Porter, P.S. 15410 (recorded November 24, 1975, L. 210, P. 557, Presque Isle County Records).
 Witnesses found (as recorded):
 Due N 25.43' 5" Birch
 S40°E 32' OBT - cedar stump with blaze facing pipe
 S61°W 23.20' 10" Twin Balsam
 N56°W 30.36' 7" Birch

Ratified by Peer Group
 in accordance with P.A. 345
 Chairman *Delmer E. Porter*
 Date August 29, 1994

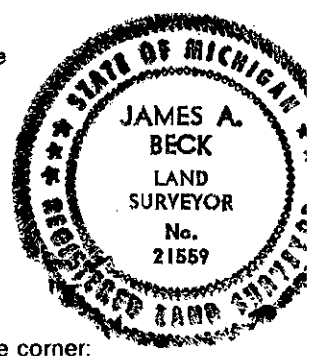

C. Description of monument for corner and accessories established to perpetuate locating the position of the corner:

M-9
 1994: 1" pipe and cap P.S. 21559 inside of pipe.
 Corner is located in thick underbrush at Northeastly corner of recently clearcut land.
 Witnesses:
 North (r) 25.43' (m) 25.09' 7" Twin Birch (P.R.)*
 S40°E 32' old stump lying blaze down (P.R.)
 S61°W 23.20' 12" Twin Dead Balsam (P.R., tag 15410-Delmer E. Porter)
 N56°W (r) 30.36' (m) 30.32' 8" Birch (P.R.)*
 N81°W 36.40' 8" Birch *
 S30°E 6.21' 4" Balsam *

P. R. = Previously Recorded
 * = Set tag P.S. 21559

Signed by *James A. Beck* Date AUGUST 25, 1994

Surveyor's Michigan License No. 21559

2459