

LAND CORNER RECORDATION CERTIFICATE
Filing Requirement of Act 74, Mich. P.A. 1970

94 SEP 12 AM 10:40

Janet M. Lamb
REGISTER OF DEEDS

For corners in
Presque Isle
(County)

Located In: Corner Code #

Table with 3 columns: Item, Located In, Corner Code #. Rows include Public Land Survey, Property Controlling in Section, and Miscellaneous Property in Sec.

LIBER 311 PAGE 234

Register of Deeds Stamp & File Number

4. Lot No. Recorded Plat
5. Private Claims

Grid table with columns A-M and rows 2-13. Contains numbers 1-36.

I, James A. Beck in a field survey on July 27, 1994, do hereby certify that under requirements of P.A. 74, Michigan P.A. of 1970, the corner points mentioned in lines 1 and 2 above were in conformance with regulations and rules therefore as required in the current manual of survey instructions of the United States Department of the Interior, Bureau of Land Management or by a decree of a Court of Law and/or that the corner points mentioned in lines 3, 4 and 5 above were in conformance with the rules of the Michigan Board of Land Surveyors or by a Decree of a Court of Law; established, re-established, monumented, re-monumented, recovered, found as expressed below:

NOTE: Not more than 4 corners, all in the same town and range, may be recorded on this certificate.


A. Description of original monument and accessories and/or subsequent restoration:

M-10 1856: Original monumentation in Government Resurvey. Set post at quarter section and referenced: Hemlock 9" N74°W 32 Links Sugar 11" S57.5°W 35 Links (circa 1972) 3/4" x 4 1/2' pipe Notes from Survey by Doyle Engineering furnished by James Granger, Granger & Associates References: N 46°30' E 86.28' 7" Maple (clump of 3) S 77°30' E 7.71' 4" Balsam S 36°00' W 17.87' 5" Balsam N 80°00' W 21.36' 4" Twin W. Pine

B. Description of corner evidence found and/or method applied in restoring or reestablishing corner:

M-10 1994: Found 3/4" iron pipe by single proportionate measure and three witnesses from survey notes by Doyle Engineering (1972). Witnesses found (as noted): N46°30' E 86.28' 7" Maple (clump of 3) S77°30' E 7.71' 4" Balsam S36°00' W 17.87' 5" Balsam

Ratified by Peer Group in accordance with P.A. 345 Chairman [Signature] Date August 29, 1994

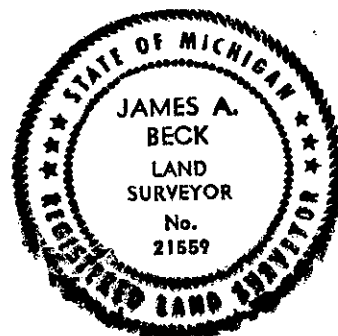

C. Description of monument for corner and accessories established to perpetuate locating the position of the corner:

M-10 1994: 3/4" pipe and cap P.S. 21559 approximately 40' West of brushed traverse line. Witnesses: N46°E (r) 86.28' (m) 87.23' 24" Fused Triple Sugar Maple (P.R.)* (r) S77°30' E 7.71' (m) S75°E 7.70' 9" Balsam (P.R.)* (r) S36°00' W 17.87' (m) S35°W 17.83' 12" Balsam (P.R.)* S15°W 48.32' 11" White Pine * N17°E 36.74' 9" Hemlock * P.R. = Previously Recorded * = Set tag P.S. 21559

Signed by James A. Beck Date August 25, 1994
Surveyor's Michigan License No. 21559