

State of Michigan Remonumentation Program
For Presque Isle County.

PRESQUE ISLE COUNTY
RECORDED

LAND CORNER RECORDATION CERTIFICATE
Filing Requirement of Act 74, Mich. P.A. 1970

94 AUG 23 AM 10:10

For corners in

PRESQUE ISLE
(County)

Located In:

Corner Code #

- | | | |
|---------------------------------------|--------------------------|-------------|
| 1. Public Land Survey | T <u>36N</u> R <u>2E</u> | <u>M-13</u> |
| | T _____ R _____ | _____ |
| | T _____ R _____ | _____ |
| | T _____ R _____ | _____ |
| 2. Property Controlling in Section | S _____ T _____ R _____ | _____ |
| | S _____ T _____ R _____ | _____ |
| 3. Miscellaneous Property in Sec. | S _____ T _____ R _____ | _____ |
| | S _____ T _____ R _____ | _____ |
| 4. Lot No. _____, Recorded Plat _____ | | |
| 5. Private Claims _____ | | |

Jane M. Lamb
REGISTER OF DEEDS

LIBER **310** PAGE **927**

Register of Deeds Stamp & File Number


I, Ronald Bischer, in a field survey on May 4, 19 94, do hereby certify that under requirements of P.A. 74, Michigan P.A. of 1970, the corner points mentioned in lines 1 and 2 above were in conformance with regulations and rules therefore as required in the current manual of survey instructions of the United States Department of the Interior, Bureau of Land Management or by a decree of a Court of Law and/or that the corner points mentioned in lines 3, 4 and 5 above were in conformance with the rules of the Michigan Board of Land Surveyors or by a Decree of a Court of Law; established, re-established, monumented, re-monumented, recovered, found as expressed below:

	A	B	C	D	E	F	G	H	I	J	K	L	M
2	6	5	4	3	2	1							
3													
4	7	8	9	10	11	12							
5													
6	18	17	16	15	14	13							
7													
8	19	20	21	22	23	24							
9													
10	30	29	28	27	26	25							
11													
12	31	32	33	34	35	36							
13													

NOTE: Not more than 4 corners, all in the same town and range, may be recorded on this certificate.

A. Description of original monument and accessories and/or subsequent restoration:

1856 Resurvey - GLO Notes	Monument with brass cap lettered
Set Wood Post	"Presque Isle County Remonumentation."
Birch 12" N77°W 35 links	N03°W 13.08' 4" Aspen
Beech 18" S54°E 28 links	S08°W 14.44' 4" Maple
	S38°W 22.70' 6" Balsam
1935+ - Marcus Schaaf	
Set 2" Pipe	
06-24-79 - Delmar E. Porter	
Found 2" Pipe - Set 4" Concrete	

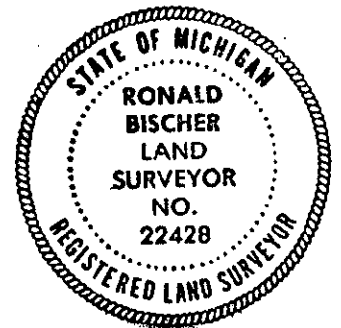

B. Description of corner evidence found and/or method applied in restoring or reestablishing corner:

Found Presque Isle County Remonumentation monument beside 2" Pipe.
N03°W 13.46' 4" Aspen
S08°W 14.61' 4" Maple
S32°W 22.82' 4" Balsam

**SURVEY &
REMONUMENTATION**

SEP 09 1994

COMMISSION

C. Description of monument for corner and accessories established to perpetuate locating the position of the corner:

Presque Isle County Remonumentation monument beside 2" pipe.
N03°W 13.46' 4" Aspen
S08°W 14.61' 4" Maple
S32°W 22.82' 4" Balsam
N39°W 27.62' 4" Aspen

Ratified by Peer Group
in accordance with P.A. 345

Chairman *Delmar E. Porter*

Date July 27, 1994

Witness tags w/nails used.

Signed by Ronald R. Bischer

Date July 20, 1994

Surveyor's Michigan License No. 22428