

1995 PRESQUE ISLE COUNTY, STATE OF MICHIGAN REMONUMENTATION

**SURVEY &**

**REMONUMENTATION**

**LAND CORNER RECORDATION CERTIFICATE**

Filing Requirement of Act 74, Mich. P.A. 1970

LIBER **316** PAGE **301**

For corners in

PRESQUE ISLE (County) JAN 17 1996 Located In:

Corner Code #

PRESQUE ISLE COUNTY  
RECORDED

95 OCT 20 PM 4:30

*Janet M. Lamb*  
REGISTER OF DEEDS

Register of Deeds Stamp & File Number

- COMMISSION**
- Public Land Survey T 36N R 2E  
T \_\_\_ R \_\_\_  
T \_\_\_ R \_\_\_  
T \_\_\_ R \_\_\_
  - Property Controlling in Section S \_\_\_ T \_\_\_ R \_\_\_  
S \_\_\_ T \_\_\_ R \_\_\_
  - Miscellaneous Property in Section S \_\_\_ T \_\_\_ R \_\_\_  
S \_\_\_ T \_\_\_ R \_\_\_

M.C. S. side  
Black Mallard  
Lake on Sec.  
line betw.  
Sec. 1 & 2  
M-P. 3

- Lot No. \_\_\_\_\_, Recorded Plat \_\_\_\_\_
- Private Claims \_\_\_\_\_

I, Ronald Bischer, in a field survey on August 25, 19 95, do hereby certify that under requirements of P.A. 74, Michigan P.A. of 1970, the corner points mentioned in lines 1 and 2 above were in conformance with regulations and rules therefore as required in the current manual of survey instructions of the United States Department of the Interior, Bureau of Land Management or by a decree of a Court of Law and/or that the corner points mentioned in lines 3, 4 and 5 above were in conformance with the rules of the Michigan Board of Professional Surveyors or by a Decree of a Court of Law; established, re-established, monumented, re-monumented, recovered, found as expressed below:

**NOTE: Not more than 4 corners, all in the same town and range, may be recorded on this certificate.**

**A. Description of original monument and accessories and/or subsequent restoration:**

1856 Resurvey - GLO Notes  
Geo. H. Cannon  
Set Wood Post  
Cedar 8" S47½°E 99 links



**B. Description of corner evidence found and/or method applied in restoring or reestablishing corner:**

Set ½" Rod and Cap #22428 by single proportion on section line, south side of Black Mallard Lake.

**C. Description of monument for corner and accessories established to perpetuate locating the position of the corner:**

½" Rod and Cap #22428  
S31°E 54.60' 4" Birch  
S06°E 14.94' 2" Cedar  
S02°W 91.38' 5" Birch  
S34°W 80.23' 4" Birch

Nails with witness tag #22428 used.

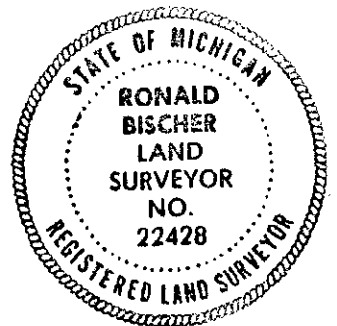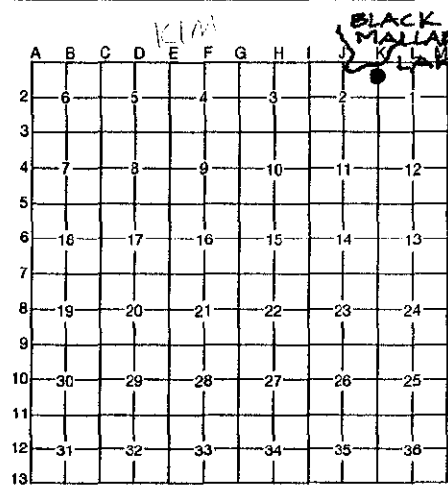

Ratified by Peer Group  
in accordance with P.A. 345/  
Chairman *Delmer E. Potter*  
Date 9/20/95

Signed by Ronald R. Bischer  
Surveyor's Michigan License No. 22428

Date Oct 3, 1995