LAND CORNER RECORDATION CERTIFICATE

Filing Requirement of Act 74, Mich. P.A. 1970

For corners in PRESQUE ISLE (County)

	Located In:	Corner Code ##
1. Public Land Survey	T 36N R 3E	L-12, M-11
	T ___ R ___	M-12
	T ___ R ___	
	T ___ R ___	
2. Property Controlling in Section	S 36 T ___ R ___	7
	S ___ T ___ R ___	
3. Miscellaneous Property in Sec.	S ___ T ___ R ___	
	S ___ T ___ R ___	

Register of Deeds Stamp & File Number

4. Lot No. _____ , Recorded Plat _____
5. Private Claims _____

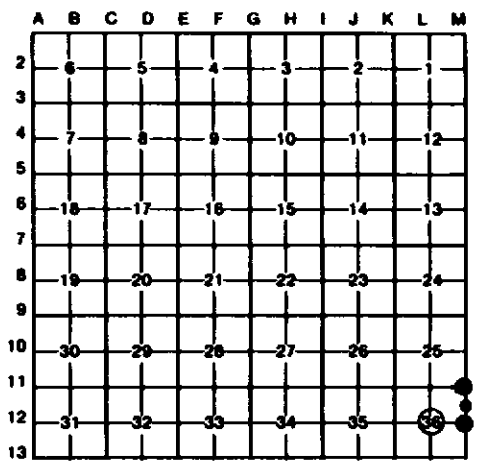

I, CARL T. KIISKILA , in a field survey on JANUARY 2 , 19 96 , do hereby certify that under requirements of P.A. 74, Michigan P.A. of 1970, the corner points mentioned in lines 1 and 2 above were in conformance with regulations and rules therefore as required in the current manual of survey instructions of the United States Department of the Interior, Bureau of Land Management or by a decree of a Court of Law and/or that the corner points mentioned in lines 3, 4 and 5 above were in conformance with the rules of the Michigan Board of Land Surveyors or by a Decree of a Court of Law; established, re-established, monumented, re-monumented, recovered, found as expressed below:

NOTE: Not more than 4 corners, all in the same town and range, may be recorded on this certificate.

A. Description of original monument and accessories and/or subsequent restoration:

L-12 M-11 M-12 7

(NO EVIDENCE OF G.L.O. CORNER, B.T'S, LINE TREES & TOPOGRAPHY, AS CALLED OUT IN THE G.L.O. LINE NOTES; UNLESS NOTED IN ITEM "B" BELOW.)

STATE OF MICHIGAN
CARL KIISKILA
LAND SURVEYOR
No. 33981
LICENSED LAND SURVEYOR

B. Description of corner evidence found and/or method applied in restoring or reestablishing corner:

L-12
FOUND AND ACCEPTED A 5/8" CAPPED IRON AS SET AND WITNESSED BY MDNR SURVEYOR KEN OSTLING, R.L.S. #10068, IN 1983 SURVEY OF S-36. CENTER OF E-W ROAD IS 24' SOUTH.

M-11
FD AND ACCEPTED A 1/2" PIPE AS WITNESSED BY DELMER PORTER IN 1981 AND USED DURING SUBSEQUENT (1983) SURVEY BY MDNR SURVEYOR K. OSTLING.

M-12
FD AND ACCEPTED A 3/4" PIPE AS WITNESESSED BY P.S. D. PORTER IN 1981 AND USED DURING SUBSEQUENT SURVEY BY MDNR SURVEYOR K.OSTLING IN 1983. N-S 2-TRACK IS 11' WEST.

7
ESTABLISHED THE SE CORNER OF THE NE1/4 OF THE NE1/4 OF SEC 36 PER STANDARD BLM PROCEDURE FOR SUBDIVISION OF A SECTION. WEST EDGE OF CLEAR CUT IS 7' WEST. NORTH END OF DIRT RD FORM SOUTH IS 50' SOUTH. COR WOULD BE ON THE APPROX. CTR LINE OF THE ROAD TO SOUTH WERE IT EXTENDED NORTH.

C. Description of monument for corner and accessories established to perpetuate locating the position of the corner:

L-12
FD. 5/8" REBAR W/PS CAP AND CEDAR POST.

12" OAK	S14°E	66.16'
11" OAK	S39°W	66.01'
#16" OAK	S40°E	11.56'
#14" OAK	N07°W	18.54'

K.OSTLING 1983 WIT.

M-11
SET DNR MON OVER FD 1/2" PIPE. SET CARSONITE POST 1' N.

6" CEDAR	N48°W	17.95'
#6" CEDAR	N48°E	11.19'
#10" CEDAR	S60°E	10.25'
#14" CEDAR	S22°W	24.31'

D.PORTER, PS#15410, WIT. SEE LCRC PG. 536.

M-12
SET 5/8"x 36" REBAR W/CAP INSIDE OF FOUND 3/4" PIPE. SET CARSONITE POST 1' NORTH.

3" J.PINE	S81°W	39.16'
#13" OAK	N34°W	45.77'
8" OAK	N43°E	35.44'
#8" J.PINE	S87°E	3.53'

D.PORTER WIT.- SEE LCRC PG.536.

7
SET 1"x 72" PIPE W/CAP. SET CARSONITE POST 1' EAST.

14" CEDAR	N54°W	24.96'
16" W.PINE	S59°W	16.50'
12" CEDAR	S20°W	33.52'
20" CEDAR	N63°E	120.60'

Signed by Carl T. Kiiskila 33981 Date 1-31-96

Surveyor's Michigan License No. _____

FORM APPROVED BY MICHIGAN STATE BOARD OF LAND SURVEYORS, JAN. 28, 1971
REVISED MAY 14, 1976
REVISED JAN., 1983