

**LAND CORNER RECORDATION CERTIFICATE**  
**Filing Requirement of Act 74, Mich. P.A. 1970**

For corners in

<u>Presque Isle</u> (County)	Located In:	Corner Code #
1. Public Land Survey	T 36N R 3E	B-12
	T R	
2. Property Controlling in Section	S 31 T 36N R 3E	12
	S T R	
3. Miscellaneous Property in Sec.	S T R	
	S T R	

**Register of Deeds Stamp & File Num**

4. Lot No. \_\_\_\_\_, Recorded Plat \_\_\_\_\_

5. Private Claims \_\_\_\_\_

I, Carl T. Kiiskila, in a field survey on July 19, 19 99 do hereby state that under requirements of P.A. 74, Michigan P.A. of 1970, the corner points mentioned in lines 1 and 2 above were in conformance with regulations and rules therefore as required in the current manual of survey instructions of the United States Department of the Interior, Bureau of Land Management or by a decree of a Court of Law and /or that the corner points mentioned in lines 3, 4 and 5 above were in conformance with the rules of the Michigan Board of Land Surveyors or by a Decree of a Court of Law; established, re-established, monumented, recovered, found as expressed below:

A	B	C	D	E	F	G	H	I	J	K	L	M
1												
2	6		5		4		3		2		1	
3												
4	7		8		9		10		11		12	
5												
6	18		17		16		15		14		13	
7												
8	19		20		21		22		23		24	
9												
10	30		29		28		27		26		25	
11												
12	31		32		33		34		35		36	
13												

**NOTE:** Not more than 2 corners, all in the same town and range, may be recorded on this certificate.

**A. Description of original monument and accessories and/or subsequent restoration:**

B-12 This position was not established during the original government survey.	12 - This position was not established during the original government survey.
---	---


**B. Description of corner evidence found and/or method applied in restoring or reestablishing corner:**

B-12 Established the Center of Section 31 at the intersection of the north-south and east-west one-quarter lines.	12 - Established the Northeast corner of the Southeast quarter of the Southwest quarter of Section 31 per standard B.L.M. instructions for subdivision of a section.
---	--

**C. Description of monument for corner and accessories established to perpetuate locating the position of the corner:**

B-12 Set a 5/8" x 32" reroed with PS cap and set a carsonite marker post.	12 - Set a 5/8" x 32" reroed with PS cap.
Wit: Set nail in 5" Maple N 41° W 33.24'	Wit: Set nail in 10" W. Birch S 52° W 148.19'
Set nail in 8" Maple N 38° E 33.83'	Set nail in 16" W. Birch S 85° W 163.79'
Set nail in 4" Maple S 85° E 9.43'	Set nail in 8" R. Pine N 76° W 166.40'
Set nail in 5" twin Maple S 52° W 39.49'	Set nail in 26" Maple N 41° W 205.45'
North-south fence West 163'	North-south fence and west edge of field West 110'
Carsonite post North 1'	

Signed by Carl T. Kiiskila  
 Surveyor's Michigan License No. 33981

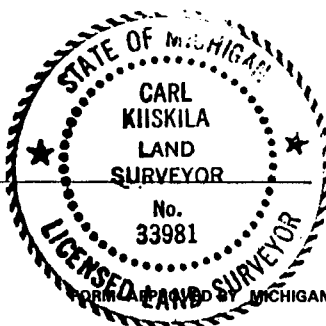

Date 8-2-99