

8935
 FEB 18 1994
 COMMISSION

ROSCOMMON COUNTY REMONUMENTATION

STATE OF MICHIGAN
 COUNTY OF ROSCOMMON

LAND CORNER RECORDATION CERTIFICATE
 Filing Requirement of Act 74, Mich. P.A. 1970

Dec 16 9 18 AM '93

For corners in

Roscommon (County)	Located In:	Corner Code #
1. Public Land Survey	T 21N R 1W	A-7
	T _____ R _____	_____
	T _____ R _____	_____
	T _____ R _____	_____
2. Property Controlling in Section	S _____ T _____ R _____	_____
	S _____ T _____ R _____	_____
3. Miscellaneous Property in Sec.	S _____ T _____ R _____	_____
	S _____ T _____ R _____	_____

ROSCOMMON COUNTY
 PEER GROUP APPROVAL
 DATE 11-30-93

TO BE FILED IN LIBER 3 OF LAND
 CORNERS
 Register of Deeds Stamp & File Number

4. Lot No. _____, Recorded Plat _____
 5. Private Claims _____

	A	B	C	D	E	F	G	H	I	J	K	L	M
2	6	5	4	3	2	1							
3													
4	7	8	9	10	11	12							
5													
6	18	17	16	15	14	13							
7													
8	19	20	21	22	23	24							
9													
10	30	29	28	27	26	25							
11													
12	31	32	33	34	35	36							
13													

I, Larry L. Cavanagh, in a field survey on November, 1993, do hereby certify that under requirements of P.A. 74, Michigan P.A. of 1970, the corner points mentioned in lines 1 and 2 above were in conformance with regulations and rules therefore as required in the current manual of survey instructions of the United States Department of the Interior, Bureau of Land Management or by a decree of a Court of Law and/or that the corner points mentioned in lines 3, 4 and 5 above were in conformance with the rules of the Michigan Board of Land Surveyors or by a Decree of a Court of Law; established, re-established, monumented, re-monumented, recovered, found as expressed below:

NOTE: Not more than 4 corners, all in the same town and range, may be recorded on this certificate.

A. Description of original monument and accessories and/or subsequent restoration:

W/post placed by John Brink 1837	1947 George D. Henning survey
Birch 16" N34°W 54	1"x24" iron bar in cor
Birch 11" S46°W 24	BT - 6" Maple S38°E 39.5
	BT - 16" Aspen N33°E 47.2
W/post found by Wm A. Burt 1850	Steel fence post set 33' East
Birch 22" N64°E 39	1975± Liber 2 corner record
Birch 16" S48°E 66	1"x24" Iron bar
	6" Maple S38°E 39.5
	16" Aspen N33°E 47.2
	Steel fence post set 33' East


B. Description of corner evidence found and/or method applied in restoring or reestablishing corner:

Fd Maple (Now 16") SE
 Pipe was fd by L. L. Cavanagh in 1974 property survey. Corner believed to be destroyed by Road Construction, re-set by above witnesses & proportionate measurement from corner to the South to 1/4 corner to the North, fits distance to 1/4 East, 1947 Henning survey and is accepted as a careful and faithful reestablishment of the position of the original corner.

See filed dossier for detail of report.

C. Description of monument for corner and accessories established to perpetuate locating the position of the corner:

Set Roscommon Co. Std. Mon in Pav't box stamped A-M-7 17614
 S40°E Nail & tag in 16" Maple 40.04
 N82°W Nail & tag in 12" Beech 67.73
 N28°W Nail & tag in P. pole 111.98
 N46°E Nail & tag in 6" Tw Beech 54.60

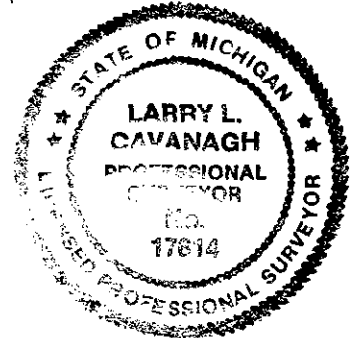

Signed by Larry L. Cavanagh

Date 12-15-93

Surveyor's Michigan License No. 17614

FORM APPROVED BY MICHIGAN STATE BOARD OF LAND SURVEYORS, JAN. 28, 1971
 REVISED MAY 14, 1975
 REVISED JAN., 1993

Date November 30, 1993 Peer Group Approved