

**SURVEY &
REMONUMENTATION**

APR 07 1998

9203 SECTION

**LAND CORNER RECORDATION CERTIFICATE
Filing Requirement of Act 74, Mich. P.A. 1970**

For Corners in <u>Roscommon</u> (County)	Located In:	Corner Code #
1. Public Land Survey	T <u>21N</u> R <u>1W</u>	<u>B-3</u>
	T _____ R _____	_____
	T _____ R _____	_____
	T _____ R _____	_____
2. Property Controlling in Section	S _____ T _____ R _____	_____
	S _____ T _____ R _____	_____
3. Miscellaneous Property in Sec.	S _____ T _____ R _____	_____
	S _____ T _____ R _____	_____

STATE OF MICHIGAN
ROSCOMMON COUNTY
RECORDED

16 DEC 97 10:16 A.M.

ROBERT W. SMITH
REGISTER OF DEEDS

**FILE IN LIBER 3 OF LAND CORNERS
Register of Deeds Stamp & File Number**

4. Lot No. _____, Recorded Plat _____
5. Private Claims _____

I, Gerald J. Gray, in a field survey on June 1, 1993, do hereby certify that under requirements of P.A. 74, Michigan P.A. of 1970, the corner points mentioned in lines 1 and 2 above were in conformance with regulations and rules therefore as required in the current manual of survey instructions of the United States Department of the Interior, Bureau of Land Management or by a decree of a Court of Law and/or that the corner points mentioned in lines 3, 4, and 5 above were in conformance with the rules of the Michigan Board of Land Surveyors or by a Decree of a Court of Law; established, re-established, monumented, re-monumented, recovered, found as expressed below:

Note: Not more than 4 corners, all in the same town and range, may be recorded on this certificate.

A. Description of original monument and accessories and/or subsequent restoration:

- WM A. Burt, 1850
Birch 12 S10W 15
Oak 6 N78E 23
- G.F. Delamater, 1935, Set 1/2" Bar 75' S. of lake
Y. Pine 10, N50E 47.0'
Y. Pine 10, N34W 15.9'

B. Description of corner evidence found and/or method applied in restoring or reestablishing corner:

Found 1/2" steel rod on peninsula, edge of water 6' south, 60' north and 55' west, woods lake
Found one Delamater witness

C. Description of monument for corner and accessories established to perpetuate locating the position of the corner:

Set Standard Roscommon County Monument


Found Brass Tag	12" R. Pine	N52°E 15.85'
Set Nail	24" W. Pine	S82°E 33.22'
Set Nail	15" R. Oak	S64°W 4.95'
Set Nail	20" B. Oak	N08°W 26.20'

	A	B	C	D	E	F	G	H	I	J	K	L	M
1													
2	6	5	4	3	2	1							
3	7	8	9	10	11	12							
4													
5													
6	18	17	16	15	14	13							
7													
8	19	20	21	22	23	24							
9													
10	30	29	28	27	26	25							
11													
12	31	32	33	34	35	36							
13													

**ROSCOMMON COUNTY
PEER GROUP APPROVAL**

DATE May 17, 1998
Marvin E. Myers
Marvin E. Myers, P.S.
County Surveyor

Signed by *Gerald J. Gray* Date _____
Surveyor's Michigan License No. 17741

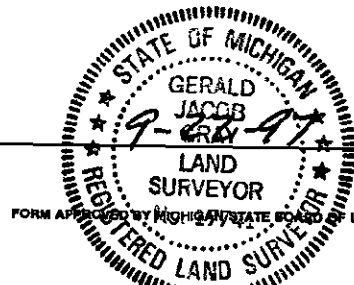

FORM APPROVED BY MICHIGAN STATE BOARD OF LAND SURVEYORS, JAN. 28, 1971
REVISED MAY 14, 1976
REVISED JAN., 1983

LIBER 3 PAGE 443