

**SURVEY &
REMONUMENTATION**

APR 07 1998

SECTION
9217

LAND CORNER RECORDATION CERTIFICATE
Filing Requirement of Act 74, Mich. P.A. 1970

For Corners in <u>Roscommon</u> (County)	Located In:	Corner Code #
1. Public Land Survey	T <u>21N</u> R <u>1W</u>	<u>B-5</u>
	T _____ R _____	_____
	T _____ R _____	_____
	T _____ R _____	_____
2. Property Controlling in Section	S _____ T _____ R _____	_____
	S _____ T _____ R _____	_____
3. Miscellaneous Property in Sec.	S _____ T _____ R _____	_____
	S _____ T _____ R _____	_____

STATE OF MICHIGAN
ROSCOMMON COUNTY
RECORDED

16 DEC 97 10:18 A.M.

ROBERT W. SMITH
REGISTER OF DEEDS

FILE IN LIBER 3 OF LAND CORNERS
Register of Deeds Stamp & File Number

4. Lot No. _____, Recorded Plat _____
5. Private Claims _____

I, Gerald J. Gray, in a field survey on May 11, 1994, do hereby certify that under requirements of P.A. 74, Michigan P.A. of 1970, the corner points mentioned in lines 1 and 2 above were in conformance with regulations and rules therefore as required in the current manual of survey instructions of the United States Department of the Interior, Bureau of Land Management or by a decree of a Court of Law and/or that the corner points mentioned in lines 3, 4, and 5 above were in conformance with the rules of the Michigan Board of Land Surveyors or by a Decree of a Court of Law; established, re-established, monumented, re-monumented, recovered, found as expressed below:

Note: Not more than 4 corners, all in the same town and range, may be recorded on this certificate.

A. Description of original monument and accessories and/or subsequent restoration:

- WM A. Burt, 1850
W. Pine 18 S30E 26
W. Pine 16 N25W 22
- G.F. Delamater, 1935, Found iron
W. Pine 6 N43E 56.6'
B. Oak 8 S13E 24.5'

B. Description of corner evidence found and/or method applied in restoring or reestablishing corner:

Found 3/4" steel rod with 1" x 2" x 1/4" steel plate welded on top (pump handle)
2' north and 9' east of fence corner.
Found both Delamater witnesses (one dead)

ROSCOMMON COUNTY

PEER GROUP APPROVAL

DATE MAY 17, 1996

Marvin E. Myers

Marvin E. Myers, P.S.
County Surveyor


C. Description of monument for corner and accessories established to perpetuate locating the position of the corner:

Set Standard Roscommon County Monument

Set Nail	20" R. Oak	S13°E 24.78'
Set Nail	6" Maple	N16°E 30.93'
Set Nail	12" R. Oak	N47°W 43.74'
Set Nail	6" Maple	S42°W 36.16'
Fd. Blaze	18" Pine Stump	S31°E 16.61'

Signed by *Gerald J. Gray* Date _____

Surveyor's Michigan License No. 17741

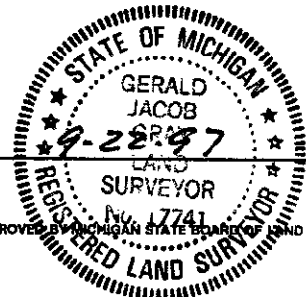

FORM APPROVED BY MICHIGAN STATE BOARD OF LAND SURVEYORS, JAN. 28, 1971
REVISED MAY 14, 1976
REVISED JAN., 1983

LIBER 3 PAGE 451