

8939

FEB 18 1994

ROSCOMMON COUNTY REMONUMENTATION

Dec 16 9 19 AM '93

LAND CORNER RECORDATION CERTIFICATE
Filing Requirement of Act 74, Mich. P.A. 1970

COMMISSION

For corners in

| Roscommon (County) | Located In: | Corner Code # |
|---------------------------------------|-------------------------|---------------|
| 1. Public Land Survey | T21N, R1W | B-9 |
| | T _____ R _____ | _____ |
| | T _____ R _____ | _____ |
| | T _____ R _____ | _____ |
| 2. Property Controlling in Section | S _____ T _____ R _____ | _____ |
| | S _____ T _____ R _____ | _____ |
| 3. Miscellaneous Property in Sec. | S _____ T _____ R _____ | _____ |
| | S _____ T _____ R _____ | _____ |
| 4. Lot No. _____, Recorded Plat _____ | | |
| 5. Private Claims _____ | | |

Robert J. Smith
REGISTER OF DEEDS

ROSCOMMON COUNTY
PEER GROUP APPROVAL
DATE 11-30-93

TO BE FILED IN LIBER 3 OF LAND CORNERS

Register of Deeds Stamp & File Number

I, Larry L. Cavanagh, in a field survey on November, 19 93, do hereby certify that under requirements of P.A. 74, Michigan P.A. of 1970, the corner points mentioned in lines 1 and 2 above were in conformance with regulations and rules therefore as required in the current manual of survey instructions of the United States Department of the Interior, Bureau of Land Management or by a decree of a Court of Law and/or that the corner points mentioned in lines 3, 4 and 5 above were in conformance with the rules of the Michigan Board of Land Surveyors or by a Decree of a Court of Law; established, re-established, monumented, re-monumented, recovered, found as expressed below:

NOTE: Not more than 4 corners, all in the same town and range, may be recorded on this certificate.

| | A | B | C | D | E | F | G | H | I | J | K | L | M |
|----|----|----|----|----|----|----|---|---|---|---|---|---|---|
| 2 | 6 | 5 | 4 | 3 | 2 | 1 | | | | | | | |
| 3 | | | | | | | | | | | | | |
| 4 | 7 | 8 | 9 | 10 | 11 | 12 | | | | | | | |
| 5 | | | | | | | | | | | | | |
| 6 | 18 | 17 | 16 | 15 | 14 | 13 | | | | | | | |
| 7 | | | | | | | | | | | | | |
| 8 | 19 | 20 | 21 | 22 | 23 | 24 | | | | | | | |
| 9 | | | | | | | | | | | | | |
| 10 | 30 | 29 | 28 | 27 | 26 | 25 | | | | | | | |
| 11 | | | | | | | | | | | | | |
| 12 | 31 | 32 | 33 | 34 | 35 | 36 | | | | | | | |
| 13 | | | | | | | | | | | | | |


A. Description of original monument and accessories and/or subsequent restoration:
 W/post placed by Wm A. Burt 1850
 Birch 18" S70°E 13
 Birch 8" N33°W 23
 1975± Liber 2 corner record
 3/4" pipe East edge of road
 1991 Survey L. Cavanagh
 1/2" bar over 3/4" pipe
 N33°E 9" R. Pine 34.5
 S45°E 31 in Power pole 31.65
 S55°W 7" Apple 52.87
 N47°W 7" Poplar 97.72
 1993 Land corner recordation
 Found capped iron of record
 S45°E 31.66 Power pole
 S56°W 53.30, 88" Apple 52.87
 N04°W 72.60, 13" Poplar

B. Description of corner evidence found and/or method applied in restoring or reestablishing corner:
 Found 1/2" bar
 (That was (in 1991) set over pipe as called for in Henning/Ostling surveys. Accepted as the best evidence of the position of the original corner.

See filed dossier for detail of report.

C. Description of monument for corner and accessories established to perpetuate locating the position of the corner:

Set Roscommon Co. Std. Mon stamped B-9 17614
 S45°E Nail & tag in Power pole 31.65
 N33°E Nail & tag in 10" R. Pine 34.84
 S55°W Nail & tag in 8" Apple 53.10
 N47°W Nail & tag in 8" Poplar 98.02
 Carsonite post East 1.98

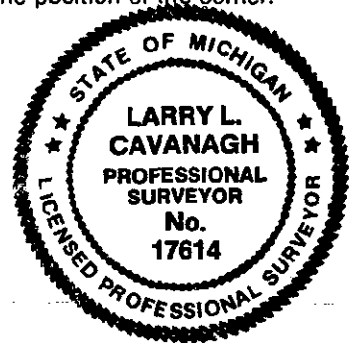

Signed by Larry L. Cavanagh Date 12-15-93
 Surveyor's Michigan License No. 17614
 Date November 30, 1993 Peer Group Approved