

12094

LAND CORNER RECORDATION CERTIFICATE
Filing Requirement of Act 74, Mich P.A. 1970

STATE OF MICHIGAN
ROSCOMMON COUNTY
RECORDED

For corners in
Roscommon County

Located in: Corner Code #

1. Public Land Survey

T21N R1W B-11
T R
T R
T R

9 DEC 1999 2:32:51 PM

ROBERT W. SMITH
REGISTER OF DEEDS

FILE IN LIBER 3 OF LAND CORNERS

Register of Deeds Stamp & File Number

I, Larry L. Cavanagh, in a field survey November, 1999, do hereby certify that under requirements of P.A. 74, Michigan P.A. of 1970, the corner points mentioned in line 1 above was in conformance with regulations and rules therefore as required in the current manual of survey instructions of the United States Department of the Interior, Bureau of Land Management or by a decree of a Court of Law; established, re-established, monumented, recovered, found as expressed below:

A. Description of original monument and accessories and/or subsequent restoration:

WILLIAM BURT 1850
SET 1/4 SECTION POST
BEECH 16° S75°E 11 LKS
BEECH 8° N8°W 9 LKS

MARK ROBINSON, JUNE 1999
L841, P147, CERTIFICATE OF SURVEY
FD SQUARE BOLT IN MON BOX
AT CENTERLINE OF GREENWOOD RD E&W
AT CENTERLINE OF NOLAND RD. N&S

LCRC L2 P31, 1970'S
MON BOX IN CO. RD. 501

TIMOTHY L. LAPHAM, AUG 1999
L849, P405, CERTIFICATE OF SURVEY
FD SQUARE BOLT IN MON BOX
AT CENTERLINE OF GREENWOOD RD., E&W
AT CENTERLINE OF NOLAN RD. N&S

LARRY L. CAVANAGH, 1991
CERTIFICATE OF SURVEY
FD SQUARE IRON IN PAV'T BOX
SPIKE IN L. POLE N50°W 44.45'
SPIKE IN F. POST S40°W 40.75'
SPIKE IN F. POST S35°E 41.05'
SPIKE IN P. POLE N45°E 66.9'

	A	B	C	D	E	F	G	H	I	J	K	L	N
2	6	5	4	3	2	1							
3													
4	7	8	9	10	11	12							
5													
6	18	17	16	15	14	13							
7													
8	19	20	21	22	23	24							
9													
10	30	29	28	27	26	25							
11	*												
12	31	32	33	34	35	36							
13													

B. Description of corner evidence found and/or method applied in restoring or reestablishing corner:

FOUND 1/2" X 20" BOLT, WITH 1" SQUARE TOP IN PAVEMENT BOX OVER 1" PIPE (NOT REMOVED)
FOUND 3 OF 4 1991 WITNESSES


THE BEST AVAILABLE EVIDENCE OF THE POSITION OF THE ORIGINAL CORNER.

C. Description of monument for corner and accessories established to perpetuate locating the position of the corner:

SET STANDARD ROSCOMMON COUNTY MONUMENT IN PAV'T BOX OVER 1" PIPE, STAMPED 17614
WIT: SPIKE IN FENCE POST S35°E 40.19'
SPIKE IN FENCE POST S38°W 50.68'
SPIKE IN LIGHT POLE N50°W 44.45'
SPIKE IN POWER POLE N45°E 66.96'

ROSCOMMON COUNTY
PEER GROUP APPROVAL
DATE NOV 30, 1999

Marvin E. Myers
Marvin E. Myers, P.S.
County Surveyor

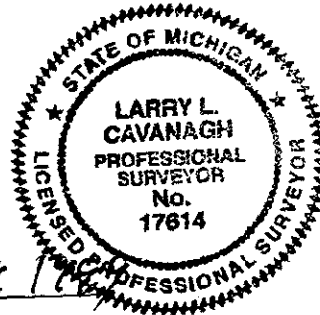

Signed by *Larry L. Cavanagh*
Surveyor's Michigan License NO. 17614

Date November 29, 1999

FORM APPROVED BY MICHIGAN STATE BOARD OF LAND SURVEYORS, JAN 28, 1971
REVISED MAY 14, 1975
REVISED JAN., 1983

LIBER 3 PAGE 626

SURVEY &
REF...
MAR 1 2000
SECTION