

SURVEY & REMONUMENTATION

APR 07 1998

SECTION
9212

LAND CORNER RECORDATION CERTIFICATE
Filing Requirement of Act 74, Mich. P.A. 1970

For Corners in <u>Roscommon</u> (County)	Located In:	Corner Code #
1. Public Land Survey	T <u>21N</u> R <u>1W</u>	<u>D-5</u>
	T _____ R _____	_____
	T _____ R _____	_____
	T _____ R _____	_____
2. Property Controlling in Section	S _____ T _____ R _____	_____
	S _____ T _____ R _____	_____
3. Miscellaneous Property in Sec.	S _____ T _____ R _____	_____
	S _____ T _____ R _____	_____

STATE OF MICHIGAN
ROSCOMMON COUNTY
RECORDED
16 DEC 97 10:17 A.M.
ROBERT W. SMITH
REGISTER OF DEEDS

FILE IN LIBER 3 OF LAND CORNERS
Register of Deeds Stamp & File Number

- 4. Lot No. _____, Recorded Plat _____
- 5. Private Claims _____

I, Gerald J. Gray, in a field survey on April 14, 1998, do hereby certify that under requirements of P.A. 74, Michigan P.A. of 1970, the corner points mentioned in lines 1 and 2 above were in conformance with regulations and rules therefore as required in the current manual of survey instructions of the United States Department of the Interior, Bureau of Land Management or by a decree of a Court of Law and/or that the corner points mentioned in lines 3, 4, and 5 above were in conformance with the rules of the Michigan Board of Land Surveyors or by a Decree of a Court of Law; established, re-established, monumented, re-monumented, recovered, found as expressed below:

Note: Not more than 4 corners, all in the same town and range, may be recorded on this certificate.

	A	B	C	D	E	F	G	H	I	J	K	L	M
1													
2	6		5		4		3		2		1		
3													
4	7		8		9		10		11		12		
5													
6	18		17		16		15		14		13		
7													
8	19		20		21		22		23		24		
9													
10	30		29		28		27		26		25		
11													
12	31		32		33		34		35		36		

A. Description of original monument and accessories and/or subsequent restoration:

- 1. WM A. Burt, 1850
W. Pine 24 S58W 47
Y. Pine 16 N20E 6
- 2. G.F. Delamater, 10/21/35, Found Gov. B's & P., Set 1/2" x 40" Bar (L..1, P. 108)
W. Oak 8, N43E 31.0'
R. Oak 8, N59W 24.9'

ROSCOMMON COUNTY
PEER GROUP APPROVAL
DATE MAY 17, 1998
Marvin E. Myers
Marvin E. Myers, P.S.
County Surveyor

B. Description of corner evidence found and/or method applied in restoring or reestablishing corner:


Found 1/2" steel rod, 2' south of E-W fence
Found both Delamater witnesses and stumps of both GLO BT's

C. Description of monument for corner and accessories established to perpetuate locating the position of the corner:

Set Standard Roscommon County Monument

- Set Nail Twin 10" W. Oak N43°E 31.19'
- Set Nail 15" R. Oak N59°W 25.46'
- Set Nail 15" B. Oak S48°E 34.02'
- Set Nail 15" B. Oak S55°W 39.12'

Signed by *Gerald J. Gray* Date _____
Surveyor's Michigan License No. 17741

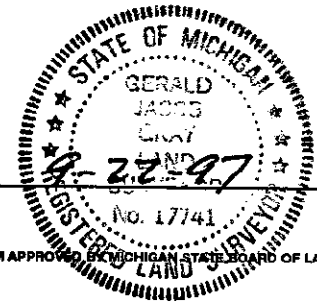

LIBER 3 PAGE 444