

**SURVEY &  
REMONUMENTATION**

APR 07 1998

SECTION  
9207

**LAND CORNER RECORDATION CERTIFICATE**  
Filing Requirement of Act 74, Mich. P.A. 1970

STATE OF MICHIGAN  
ROSCOMMON COUNTY  
RECORDED

16 DEC 97 10:16 A.M.

ROBERT W. SMITH  
REGISTER OF DEEDS

For Corners in <u>Roscommon</u> (County)	Located In:	Corner Code #
1. Public Land Survey	T <u>21N</u> R <u>1W</u>	<u>E-3</u>
	T _____ R _____	_____
	T _____ R _____	_____
	T _____ R _____	_____
2. Property Controlling in Section	S _____ T _____ R _____	_____
	S _____ T _____ R _____	_____
3. Miscellaneous Property in Sec.	S _____ T _____ R _____	_____
	S _____ T _____ R _____	_____

FILE IN LIBER 3 of LAND CORNERS

Register of Deeds Stamp & File Number

4. Lot No. \_\_\_\_\_, Recorded Plat \_\_\_\_\_  
5. Private Claims \_\_\_\_\_

I, Gerald J. Gray, in a field survey on April 7, 1993, do hereby certify that under requirements of P.A. 74, Michigan P.A. of 1970, the corner points mentioned in lines 1 and 2 above were in conformance with regulations and rules therefore as required in the current manual of survey instructions of the United States Department of the Interior, Bureau of Land Management or by a decree of a Court of Law and/or that the corner points mentioned in lines 3, 4, and 5 above were in conformance with the rules of the Michigan Board of Land Surveyors or by a Decree of a Court of Law; established, re-established, monumented, re-monumented, recovered, found as expressed below:

	A	B	C	D	E	F	G	H	I	J	K	L	M
1													
2	6		5		4		3		2		1		
3					●								
4	7		8		9		10		11		12		
5													
6	18		17		16		15		14		13		
7													
8	19		20		21		22		23		24		
9													
10	30		29		28		27		26		25		
11													
12	31		32		33		34		35		36		
13													

**Note:** Not more than 4 corners, all in the same town and range, may be recorded on this certificate.

A. Description of original monument and accessories and/or subsequent restoration:

- WM A. Burt, 1850  
Y. Pine 16, S31W 45  
Y. Pine 16, N32E 68
- G.F. Delamater, 8/8/35, Found Gov. B's, Set Pipe in Conc. (L. 1, P. 99)  
B. Oak 12, S32°E 41.3'  
R. Oak 14, S39°W 32.7'

**ROSCOMMON COUNTY  
PEER GROUP APPROVAL  
DATE** MAY 17, 1998

*Marvin E. Myers*  
**Marvin E. Myers, P.S.  
County Surveyor**

B. Description of corner evidence found and/or method applied in restoring or reestablishing corner:

Found small cairn at intersection of old witnesses. No trace of Delamater's pipe in concrete.  
Set iron in cairn.


C. Description of monument for corner and accessories established to perpetuate locating the position of the corner:

Set Standard Roscommon County Monument

- |          |                 |              |
|----------|-----------------|--------------|
| Set Nail | Twin 24" R. Oak | S39°W 32.30' |
| Set Nail | 18" B. Oak      | S31°E 40.88' |
| Set Nail | 6" R. Oak       | N59°W 4.23'  |
| Set Nail | 6" W. Pine      | N32°E 23.71' |
|          | Pine Stump      | N32°E 44.9'  |

Signed by Gerald J. Gray Date \_\_\_\_\_

Surveyor's Michigan License No. 17741

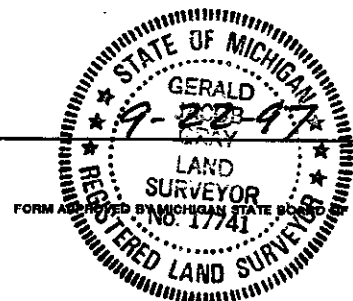

FORM APPROVED BY MICHIGAN STATE BOARD OF LAND SURVEYORS, JAN. 28, 1971  
REVISED MAY 14, 1975  
REVISED JAN., 1985

*LIBER 3 PAGE 441*