

**SURVEY &
REMONUMENTATION**

APR 07 1998

SECTION
9219

LAND CORNER RECORDATION CERTIFICATE
Filing Requirement of Act 74, Mich. P.A. 1970

STATE OF MICHIGAN
ROSCOMMON COUNTY
RECORDED

For Corners in Roscommon (County)	Located In:	Corner Code #
1. Public Land Survey	T <u>21N</u> R <u>1W</u>	<u>E-5</u>
	T _____ R _____	_____
	T _____ R _____	_____
	T _____ R _____	_____
2. Property Controlling in Section	S _____ T _____ R _____	_____
	S _____ T _____ R _____	_____
3. Miscellaneous Property in Sec.	S _____ T _____ R _____	_____
	S _____ T _____ R _____	_____

16 DEC 97 10:19 A.M.

ROBERT W. SMITH
REGISTER OF DEEDS

FILE IN LIBER 3 OF LAND CORNERS

Register of Deeds Stamp & File Number

4. Lot No. _____, Recorded Plat _____
5. Private Claims _____

I, Gerald J. Gray, in a field survey on April 14, 1993, do hereby certify that under requirements of P.A. 74, Michigan P.A. of 1970, the corner points mentioned in lines 1 and 2 above were in conformance with regulations and rules therefore as required in the current manual of survey instructions of the United States Department of the Interior, Bureau of Land Management or by a decree of a Court of Law and/or that the corner points mentioned in lines 3, 4, and 5 above were in conformance with the rules of the Michigan Board of Land Surveyors or by a Decree of a Court of Law; established, re-established, monumented, re-monumented, recovered, found as expressed below:

Note: Not more than 4 corners, all in the same town and range, may be recorded on this certificate.

	A	B	C	D	E	F	G	H	I	J	K	L	M
1													
2	6		5		4		3		2		1		
3													
4	7		8		9		10		11		12		
5													
6	18		17		16		15		14		13		
7													
8	19		20		21		22		23		24		
9													
10	30		29		28		27		26		25		
11													
12	31		32		33		34		35		36		
13													

A. Description of original monument and accessories and/or subsequent restoration:

- WM A. Burt, 1850
Y. Pine 16 N72E 24
Y. Pine 20 S14W 8
- G.F. Delamater, 6/26/1935, Found Gov. B's & P., Set 1/2" x 30" Bar (L..1, P. 77)
B. Oak 12, N55W 40.1'
B. Oak 10, S70E 2.8'
W. Oak 12, S 45 1/2 W 70.5'

B. Description of corner evidence found and/or method applied in restoring or reestablishing corner:

Found 1/2" steel rod, three Delamater witnesses and stumps of both G.L.O. B.T.'s
Set new witnesses 4/14/93
Rod pulled out of ground when tree S70E 2.8' (Delamater Wit.) knocked over by tornado 7/13/95
Re-set corner from remaining witnesses 8/26/95

Accepted position as a perpetuation of the original corner.

C. Description of monument for corner and accessories established to perpetuate local corner:

Set Standard Roscommon County Monument

- | | | |
|----------|----------------|--|
| Set Nail | 18" W. Oak | S46°W 70.81' |
| Set Nail | 24" B. Oak | N55°W 40.80' |
| Set Nail | 20" B. Oak | S70°E 3.00' (Destroyed by tornado 7/13/95) |
| Set Nail | Trip. 6" Maple | N09°E 16.54' |
| | Pine stump | N72°E 15.8' |
| | Pine stump | S14°W 5.3' |

Signed by _____ Date _____


Surveyor's Michigan License No. 17741

ROSCOMMON COUNTY

BEER GROUP APPROVAL:

DATE May 17, 1996

Marvin E. Myers
Marvin E. Myers, P.S.
County Surveyor

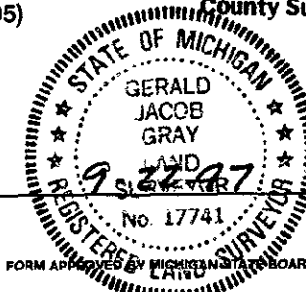

FORM APPROVED BY MICHIGAN BOARD OF LAND SURVEYORS, JAN. 28, 1971
REVISED MAY 14, 1975
REVISED JAN., 1993

LIBER 3 PAGE 453