

SURVEY & REMONUMENTATION

APR 07 1998

SECTION

9214

LAND CORNER RECORDATION CERTIFICATE
Filing Requirement of Act 74, Mich. P.A. 1970

STATE OF MICHIGAN
ROSCOMMON COUNTY
RECORDED

16 DEC 97 10:17 A.M.

ROBERT W. SMITH
REGISTER OF DEEDS

For Corners in Roscommon (County)	Located In:	Corner Code #
1. Public Land Survey	T <u>21N</u> R <u>1W</u>	<u>G-3</u>
	T _____ R _____	_____
	T _____ R _____	_____
	T _____ R _____	_____
2. Property Controlling in Section	S _____ T _____ R _____	_____
	S _____ T _____ R _____	_____
3. Miscellaneous Property in Sec.	S _____ T _____ R _____	_____
	S _____ T _____ R _____	_____

FILE IN LIBER 3 OF LAND CORNERS
Register of Deeds Stamp & File Number

4. Lot No. _____, Recorded Plat _____
5. Private Claims _____

I, Gerald J. Gray, in a field survey on June 22, 1995, do hereby certify that under requirements of P.A. 74, Michigan P.A. of 1970, the corner points mentioned in lines 1 and 2 above were in conformance with regulations and rules therefore as required in the current manual of survey instructions of the United States Department of the Interior, Bureau of Land Management or by a decree of a Court of Law and/or that the corner points mentioned in lines 3, 4, and 5 above were in conformance with the rules of the Michigan Board of Land Surveyors or by a Decree of a Court of Law; established, re-established, monumented, re-monumented, recovered, found as expressed below:

	A	B	C	D	E	F	G	H	I	J	K	L	M
1													
2	6		5		4		3		2		1		
3							●						
4	7		8		9		10		11		12		
5													
6	18		17		16		15		14		13		
7													
8	19		20		21		22		23		24		
9													
10	30		29		28		27		26		25		
11													
12	31		32		33		34		35		36		
13													

Note: Not more than 4 corners, all in the same town and range, may be recorded on this certificate.

A. Description of original monument and accessories and/or subsequent restoration:

- WM A. Burt, 1850
Aspen 6 S34W 18
W. Pine 18 S40E 48
- G.F. Delamater, 1935, Found One Gov. B. & Gas Pipe (L 1, P. 83)
W. Pine 7, N24E 68.4'
B. Oak 7, S53E 70.6'

**ROSCOMMON COUNTY
PEER GROUP APPROVAL**

DATE MAY 17, 1998
Marvin E. Myers
Marvin E. Myers, P.S.
County Surveyor

B. Description of corner evidence found and/or method applied in restoring or reestablishing corner:


Found 1 1/2" pipe in Beaver Pond

C. Description of monument for corner and accessories established to perpetuate locating the position of the corner:

Set Standard Roscommon County Monument

- Set Nail 4" W. Pine S02°E 52.94'
- Set Nail 4" W. Pine S30°E 55.52'
- Set Nail 6" W. Pine S57°E 48.58'
- Set Nail 6" Maple S60°E 32.63'

Signed by *Gerald J. Gray* Date _____
Surveyor's Michigan License No. 17741

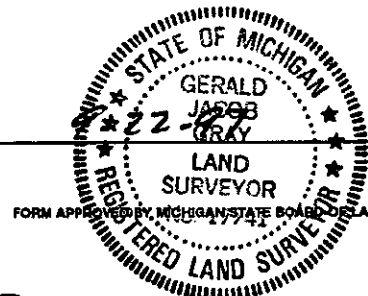

LIBER 3 PAGE 448