

SURVEY &  
REMONUMENTATION

APR 07 1998

SECTION

9215

LAND CORNER RECORDATION CERTIFICATE  
Filing Requirement of Act 74, Mich. P.A. 1970

STATE OF MICHIGAN  
ROSCOMMON COUNTY  
RECORDED

16 DEC 97 10:17 A.M.

ROBERT W. SMITH  
REGISTER OF DEEDS

For Corners in Roscommon (County)	Located In:	Corner Code #
1. Public Land Survey	T <u>21N</u> R <u>1W</u>	<u>G-4</u>
	T _____ R _____	_____
	T _____ R _____	_____
	T _____ R _____	_____
2. Property Controlling in Section	S _____ T _____ R _____	_____
	S _____ T _____ R _____	_____
3. Miscellaneous Property in Sec.	S _____ T _____ R _____	_____
	S _____ T _____ R _____	_____

FILE IN LIBER 3 OF LAND CORNERS  
Register of Deeds Stamp & File Number

4. Lot No. \_\_\_\_\_, Recorded Plat \_\_\_\_\_  
5. Private Claims \_\_\_\_\_

I, Gerald J. Gray, in a field survey on June 22, 1995, do hereby certify that under requirements of P.A. 74, Michigan P.A. of 1970, the corner points mentioned in lines 1 and 2 above were in conformance with regulations and rules therefore as required in the current manual of survey instructions of the United States Department of the Interior, Bureau of Land Management or by a decree of a Court of Law and/or that the corner points mentioned in lines 3, 4, and 5 above were in conformance with the rules of the Michigan Board of Land Surveyors or by a Decree of a Court of Law; established, re-established, monumented, re-monumented, recovered, found as expressed below:

**Note: Not more than 4 corners, all in the same town and range, may be recorded on this certificate.**

	A	B	C	D	E	F	G	H	I	J	K	L	M
1													
2	6		5		4		3		2		1		
3													
4	7		8		9		10		11		12		
5													
6	18		17		16		15		14		13		
7													
8	19		20		21		22		23		24		
9													
10	30		29		28		27		26		25		
11													
12	31		32		33		34		35		36		
13													

A. Description of original monument and accessories and/or subsequent restoration:

1. WM A. Burt, 1850  
W. Pine 16 N85W 33  
W. Pine 16 S55E 56

2. G.F. Delamater, 12/4/35, Found Pipe in Conc., Found Both Gov. B's. (L 1, P. 106)  
W. Oak 3, N54W 47.7'  
W. Oak 2, N84E 50.6'

B. Description of corner evidence found and/or method applied in restoring or reestablishing corner:  
Found 1 1/2" iron pipe in concrete, 1' below surface of abandoned North-South road grade.  
Found one Delamater witness.


C. Description of monument for corner and accessories established to perpetuate locating the position of the corner:

Set Standard Roscommon County Monument

- Set Nail 6" R. Oak N94°E 24.04'  
Set Nail 8" R. Oak S47°E 28.49'  
Set Nail 3" W. Pine S69°W 12.66'  
Set Nail 6" W. Oak N54°W 47.92'

Signed by \_\_\_\_\_ Date \_\_\_\_\_

Surveyor's Michigan License No. 17741

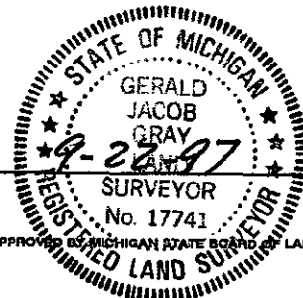

FORM APPROVED BY MICHIGAN STATE BOARD OF LAND SURVEYORS, JAN. 26, 1971  
REVISED MAY 14, 1975  
REVISED JAN., 1983

LIBER 3 PAGE 111A