

**SURVEY &  
REMONUMENTATION**

APR 07 1998

**SECTION  
9213**

**LAND CORNER RECORDATION CERTIFICATE  
Filing Requirement of Act 74, Mich. P.A. 1970**

STATE OF MICHIGAN  
ROSCOMMON COUNTY  
RECORDED

For Corners in <u>Roscommon</u> (County)	Located In:	Corner Code #
1. Public Land Survey	T <u>21N</u> R <u>1W</u>	<u>G-5</u>
	T _____ R _____	_____
	T _____ R _____	_____
	T _____ R _____	_____
2. Property Controlling in Section	S _____ T _____ R _____	_____
	S _____ T _____ R _____	_____
3. Miscellaneous Property in Sec.	S _____ T _____ R _____	_____
	S _____ T _____ R _____	_____

16 DEC 97 10:17 A.M.

ROBERT W. SMITH  
REGISTER OF DEEDS

**FILE IN LIBER 3 OF LAND CORNERS**  
Register of Deeds Stamp & File Number

4. Lot No. \_\_\_\_\_, Recorded Plat \_\_\_\_\_  
5. Private Claims \_\_\_\_\_

I, Gerald J. Gray, in a field survey on May 11, 1994, do hereby certify that under requirements of P.A. 74, Michigan P.A. of 1970, the corner points mentioned in lines 1 and 2 above were in conformance with regulations and rules therefore as required in the current manual of survey instructions of the United States Department of the Interior, Bureau of Land Management or by a decree of a Court of Law and/or that the corner points mentioned in lines 3, 4, and 5 above were in conformance with the rules of the Michigan Board of Land Surveyors or by a Decree of a Court of Law; established, re-established, monumented, re-monumented, recovered, found as expressed below:

**Note: Not more than 4 corners, all in the same town and range, may be recorded on this certificate.**

A. Description of original monument and accessories and/or subsequent restoration:

- 1) Wm. A. Burt 1850  
Cedar 6 N10W 28  
W. Pine 6 S57W 25
- 2) G.F. Delamater 1935, L. 1, P. 77  
Found both Gov. B's, & P.  
Set 1/2" iron rod  
Cedar 4, S48W 30.3'  
Cedar 3, S39E 25.9'  
(90' S. of R.R. grade, L. 1, P. 106)

B. Description of corner evidence found and/or method applied in restoring or reestablishing corner:

Found capped iron (P.B. Lapham) 3' north of E-W fence  
90'± S. of centerline railroad grade road at Delamater's record distance (2618.4') from corner F-5

C. Description of monument for corner and accessories established to perpetuate locating the position of the corner:

Set Standard Roscommon County Monument

Set Nail	6" Cedar	N64°E 21.90'
Set Nail	6" Cedar	S04°W 9.84'
Fd. Nail	10" Tamarack	S70°W 24.15'
Fd. Nail	6" Cedar	N32°W 22.05'


	A	B	C	D	E	F	G	H	I	J	K	L	M
1													
2	6		5		4		3		2		1		
3													
4	7		8		9		10		11		12		
5													
6	18		17		16		15		14		13		
7													
8	19		20		21		22		23		24		
9													
10	30		29		28		27		26		25		
11													
12	31		32		33		34		35		36		
13													

**ROSCOMMON COUNTY  
PEER GROUP APPROVAL**

DATE MAY 17, 1996

*Marvin E. Myers*  
Marvin E. Myers, P.S.  
County Surveyor

Signed by *Gerald J. Gray* Date \_\_\_\_\_  
Surveyor's Michigan License No. 17741

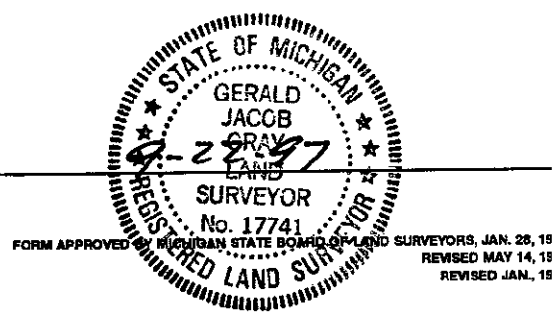

LIBER 3 PAGE 447