

**SURVEY &
REMONUMENTATION**

APR 07 1998

**SECTION
9218**

**LAND CORNER RECORDATION CERTIFICATE
Filing Requirement of Act 74, Mich. P.A. 1970**

STATE OF MICHIGAN
ROSCOMMON COUNTY
RECORDED

16 DEC 97 10:19 A.M.

ROBERT W. SMITH
REGISTER OF DEEDS

For Corners in Roscommon (County)	Located In:	Corner Code #
1. Public Land Survey	T <u>21N</u> R <u>1W</u>	<u>H-3</u>
	T _____ R _____	_____
	T _____ R _____	_____
	T _____ R _____	_____
2. Property Controlling in Section	S _____ T _____ R _____	_____
	S _____ T _____ R _____	_____
3. Miscellaneous Property in Sec.	S _____ T _____ R _____	_____
	S _____ T _____ R _____	_____

FILE IN LIBER 3 OF LAND CORNERS
Register of Deeds Stamp & File Number

4. Lot No. _____, Recorded Plat _____
5. Private Claims _____

I, Gerald J. Gray, in a field survey on June 22, 1995, do hereby certify that under requirements of P.A. 74, Michigan P.A. of 1970, the corner points mentioned in lines 1 and 2 above were in conformance with regulations and rules therefore as required in the current manual of survey instructions of the United States Department of the Interior, Bureau of Land Management or by a decree of a Court of Law and/or that the corner points mentioned in lines 3, 4, and 5 above were in conformance with the rules of the Michigan Board of Land Surveyors or by a Decree of a Court of Law; established, re-established, monumented, re-monumented, recovered, found as expressed below:

Note: Not more than 4 corners, all in the same town and range, may be recorded on this certificate.

A. Description of original monument and accessories and/or subsequent restoration:

- WM A. Burt, 1850
Spruce Pine 10, N11W 92
Spruce Pine 4, S45W 10
- G.F. Delamater, 1935, Set 1/2" Iron Rod, M.W.O.L. (L. 1, P. 83)
B. Oak 14, N27°E 31.3'
S. Pine 12, S51°E 29.9'

B. Description of corner evidence found and/or method applied in restoring or reestablishing corner:

Found 1 1/2" pipe in center of east-west road.
Delamater's witnesses still standing, but both dead.

C. Description of monument for corner and accessories established to perpetuate location of the corner:

Set Standard Roscommon County Monument


- | | | |
|----------|-------------|--------------|
| Set Nail | 5" J. Pine. | N29°E 9.50' |
| Set Nail | 3" R. Pine | S52°E 22.44' |
| Set Nail | 5" B. Oak | South 24.38' |
| Set Nail | 4" Maple | N46°W 38.86' |

	A	B	C	D	E	F	G	H	I	J	K	L	M
1													
2	6	5	4	3	2	1							
3													
4	7	8	9	10	11	12							
5													
6	18	17	16	15	14	13							
7													
8	19	20	21	22	23	24							
9													
10	30	29	28	27	26	25							
11													
12	31	32	33	34	35	36							
13													

**ROSCOMMON COUNTY
PEER GROUP APPROVAL
DATE MAY 17, 1996**

Marvin E. Myers
Marvin E. Myers, P.S.

Signed by Gerald J. Gray Date _____
Surveyor's Michigan License No. 17741

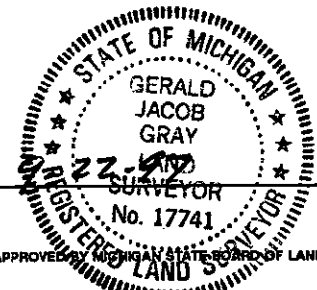

LIBER 3 PAGE 452