

MICHIGAN
DEPARTMENT OF CONSERVATION
FORESTRY DIVISION

LAND CORNER RECORD

T. 21 N.R. 3 W


Roscommon COUNTY

DESCRIPTION OF CORNER 1/4 corner on South Side Section 32 T21NR3W

CORNER MONUMENT Set 1" pipe with 4" aluminum cap

DATE MONUMENT PLACED AND WITNESSED 11-17-66

WITNESSES TO CORNER.....

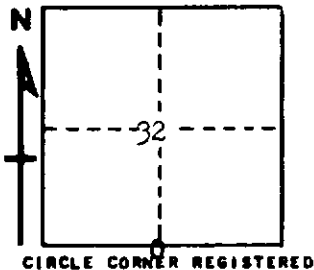

7" Cedar N 56 E 16.9'

7" H. Maple N 43 W 23.9'

AND

DESCRIPTION IN DETAIL AS TO HOW CORNER WAS LOCATED AND IDENTIFIED OR RESTORED.

This corner was set by proportionate measurement, midpoint on line between section corners. Nothing conclusive for USBTs, although a Schaaf corner was found, lying down, about 15' NW of our position. 1/4 corner for Section 5 is 10.205 chs. east.

SURVEYOR'S SEAL

SIGNED *Kenneth J. Ostling* DATE 11-29-66
REGISTERED LAND SURVEYOR #10063