LAND CORNER RECORDATION CERTIFICATE

Filing Requirement of Act 74, Mich. P.A. 1970

For corners in ROSCOMMON (County)

	Located In:	Corner Code #t
1. Public Land Survey	T 21N R 3W	B-13
	T ___ R ___	
	T ___ R ___	
	T ___ R ___	
2. Property Controlling	S 31 T ___ R ___	15
in Section	S ___ T ___ R ___	
3. Miscellaneous	S ___ T ___ R ___	
Property in Sec.	S ___ T ___ R ___	

Register of Deeds Stamp & File Number

4. Lot No. _____ , Recorded Plat _____
5. Private Claims _____

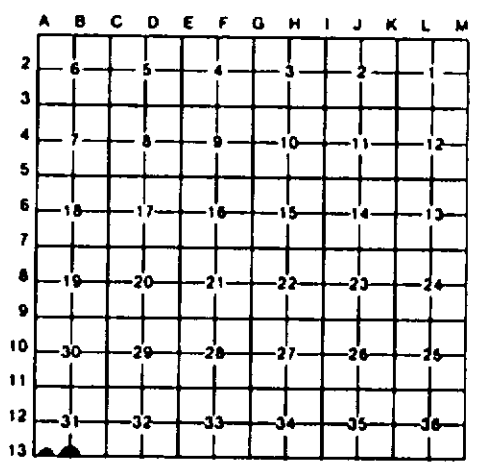

I, C.F.ROSER, in a field survey on MAY 6, 19 92, do hereby certify that under requirements of P.A. 74, Michigan P.A. of 1970, the corner points mentioned in lines 1 and 2 above were in conformance with regulations and rules therefore as required in the current manual of survey instructions of the United States Department of the Interior, Bureau of Land Management or by a decree of a Court of Law and/or that the corner points mentioned in lines 3, 4 and 5 above were in conformance with the rules of the Michigan Board of Land Surveyors or by a Decree of a Court of Law; established, re-established, monumented, re-monumented, recovered, found as expressed below:

NOTE: Not more than 4 corners, all in the same town and range, may be recorded on this certificate.

A. Description of original monument and accessories and/or subsequent restoration:

B-13
15

B. Description of corner evidence found and/or method applied in restoring or reestablishing corner:

B-13: FD. CONSERVATION DEPT. MON. FOR S1/4 COR. SEC. 31, T21N-R3W. K.OSTLING SET COR BY PROPORTIONATE MEASUREMENT TO U.S.(G.L.O. RUN-OUT SEC.) BETWEEN RESTORED SEC CORNERS IN 1966. E-W TRAIL IS 112' S.

15: FD 1" GALV. PIPE FOR SW COR OF SE1/4 OF FRL. SW1/4 OF SEC 31, T21N-R3W. K.OSTLING SET COR. BY PROPORTIONATE MEAS. TO U.S. (G.L.O. RUN-OUT SEC.) BETWEEN RESTORED GOVT. CORS IN 1966.

C. Description of monument for corner and accessories established to perpetuate locating the position of the corner:

B-13: FD. CONSV. DEPT. MON, ADDED CEDAR POST.

#8"BALSAM	WEST	26.3'
16"MAPLE	N15°W	33.6'
#9"CEDAR	NORTH	7.7'
7" CEDAR	N70°E	48.6'

#= LS, K.OSTLING WIT.

15: FD 1" GALV. PIPE, ADDED CEDAR POST W/LOC TAG.

#10"BALSAM	N85°W	8.9'
6"MAPLE	N05°W	5.4'
7"MAPLE	N30°E	13.4'
10"CEDAR	N80°E	51.3'

#= LS, K.OSTLING WIT.

STATE OF MICHIGAN
CARL F. ROSER
LAND SURVEYOR
No. 12023
REGISTERED LAND SURVEYOR

Signed by Carl F. Roser 3-29-94 Date _____

Surveyor's Michigan License No. 12028

FORM APPROVED BY MICHIGAN STATE BOARD OF LAND SURVEYORS, JAN. 26, 1971
REVISED MAY 14, 1975
REVISED JAN., 1983