

LAND CORNER RECORDATION CERTIFICATE
Filing Requirement of Act 74, Mich. P.A. 1970

For corners in
ROSCOMMON
 (County)

Located In: _____ Corner Code ##

- | | | |
|------------------------------------|--------------------------|-------------------|
| 1. Public Land Survey | T <u>21N</u> R <u>4W</u> | <u>J-13, H-13</u> |
| | T _____ R _____ | _____ |
| | T _____ R _____ | _____ |
| | T _____ R _____ | _____ |
| 2. Property Controlling in Section | S _____ T _____ R _____ | _____ |
| | S _____ T _____ R _____ | _____ |
| 3. Miscellaneous Property in Sec. | S _____ T _____ R _____ | _____ |
| | S _____ T _____ R _____ | _____ |

Register of Deeds Stamp & File Number

4. Lot No. _____, Recorded Plat _____
5. Private Claims _____

	A	B	C	D	E	F	G	H	I	J	K	L	M
2	6	5	4	3	2	1							
3													
4	7	8	9	10	11	12							
5													
6	18	17	16	15	14	13							
7													
8	19	20	21	22	23	24							
9													
10	30	29	28	27	26	25							
11													
12	31	32	33	34	35	36							
13													

I, C.F. ROSER, in a field survey on MAY 7, 19 92, do hereby certify that under requirements of P.A. 74, Michigan P.A. of 1970, the corner points mentioned in lines 1 and 2 above were in conformance with regulations and rules therefore as required in the current manual of survey instructions of the United States Department of the Interior, Bureau of Land Management or by a decree of a Court of Law and/or that the corner points mentioned in lines 3, 4 and 5 above were in conformance with the rules of the Michigan Board of Land Surveyors or by a Decree of a Court of Law; established, re-established, monumented, re-monumented, recovered, found as expressed below:

NOTE: Not more than 4 corners, all in the same town and range, may be recorded on this certificate.

A. Description of original monument and accessories and/or subsequent restoration:

J-13 H-13


B. Description of corner evidence found and/or method applied in restoring or reestablishing corner:

J-13	H-13
FD CONSERVATION DEPT. MON. FOR S1/4 COR OF SEC. 35, T21N-R4W. K.OSTLING SET THIS COR BY PROPORTIONATE MEASUREMENT BETWEEN SEC. CORNERS WHILE MAKING A RETRACEMENT OF THE CORRECTION LINE, IN 1966.	FD. CONSERVATION DEPT. MON. FOR S1/4 COR SEC 34, T21N-R4W. K.OSTLING ESTABLISHED BY PROPORTIONATE MEASUREMENT BETWEEN SECTION CORNERS OF SEC 34, IN 1966.

C. Description of monument for corner and accessories established to perpetuate locating the position of the corner:

J-13	H-13
FD. CONSV. DEPT. MON.	FD. CONSV. DEPT. MON. AND ADDED CEDAR POST.
813"MAPLE(CLP) N19°W 126.8'	14"W.BIRCH N55°W 25.6'
4" BALSAM N85°E 18.0'	813"SPRUCE N65°E 14.1'
7"W.PINE S55°E 28.4'	11"TW.MAPLE S30°E 6.0'
817"AMARACK S23°E 120.3'	13"CEDAR N85°W 56.1'

8= K.J.OSTLING MIT. 8= RLS,K.OSTLING MIT.

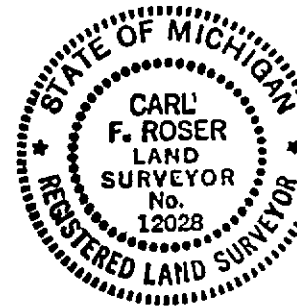

Signed by Carl F. Roser 3-29-94 Date _____

Surveyor's Michigan License No. 12028